BRITTNI AND SEAN DOYLE

C-56500, C-56499, C-45063

HISTORIC POD & APOD APPLICATION

○ AUTHORIZED POD (C-56500)
50' S 50' E OF NW 1/4 SW SE SECTION 27 T37S R5W

● HISTORIC POD (C-56500); HISTORIC APOD (C-56499, C-45063)
720' S 365' E OF NW 1/4 SW SE SECTION 27 T37S R5W

0 200 400 ft

This map is not intended to provide legal dimensions or locations of property ownership lines

C-56500 POU
4.14 ACS NE SE
12.9 ACS NW SE
5.7 ACS SW SE
5.6 ACS SE SE
UNCHANGED

C-56499 POU
3.4 ACS NW SE
2.8 ACS SW SE
0.8 ACS SE SE
UNCHANGED

C-45063 POU
0.2 ACS SE SE
UNCHANGED

27

26

NW CORNER SWSE SECTION 27

PIPELINES

T37S R05W

NWSE

NESE

0520

NORTHSIDE APPLEGATE RIVER DITCH

APPLEGATE RIVER

0501


0502

SWSE

SESE

SWSW

AUTHORIZED POD (C-56499, C-45063);
HISTORIC APOD (C-56500)

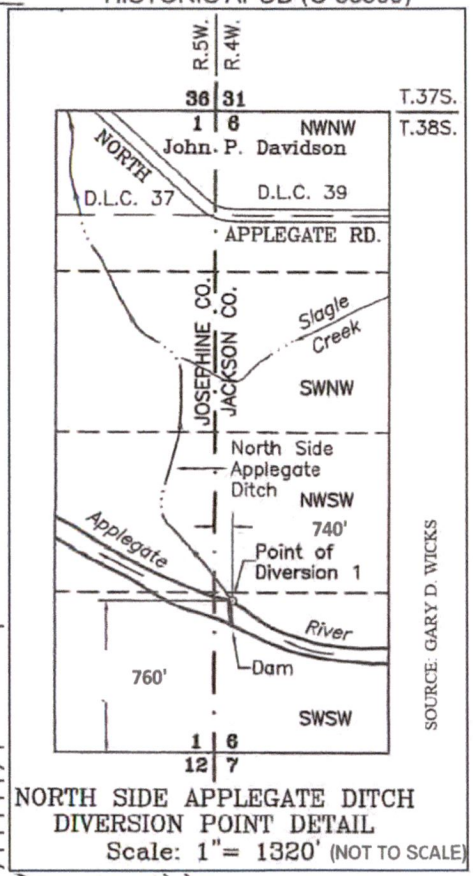

NORTH SIDE APPLEGATE DITCH
DIVERSION POINT DETAIL
Scale: 1"= 1320' (NOT TO SCALE)

Received
JUL 15 2024
OWRD

14502 -