T. 24 S., R. 29 E., W.M.

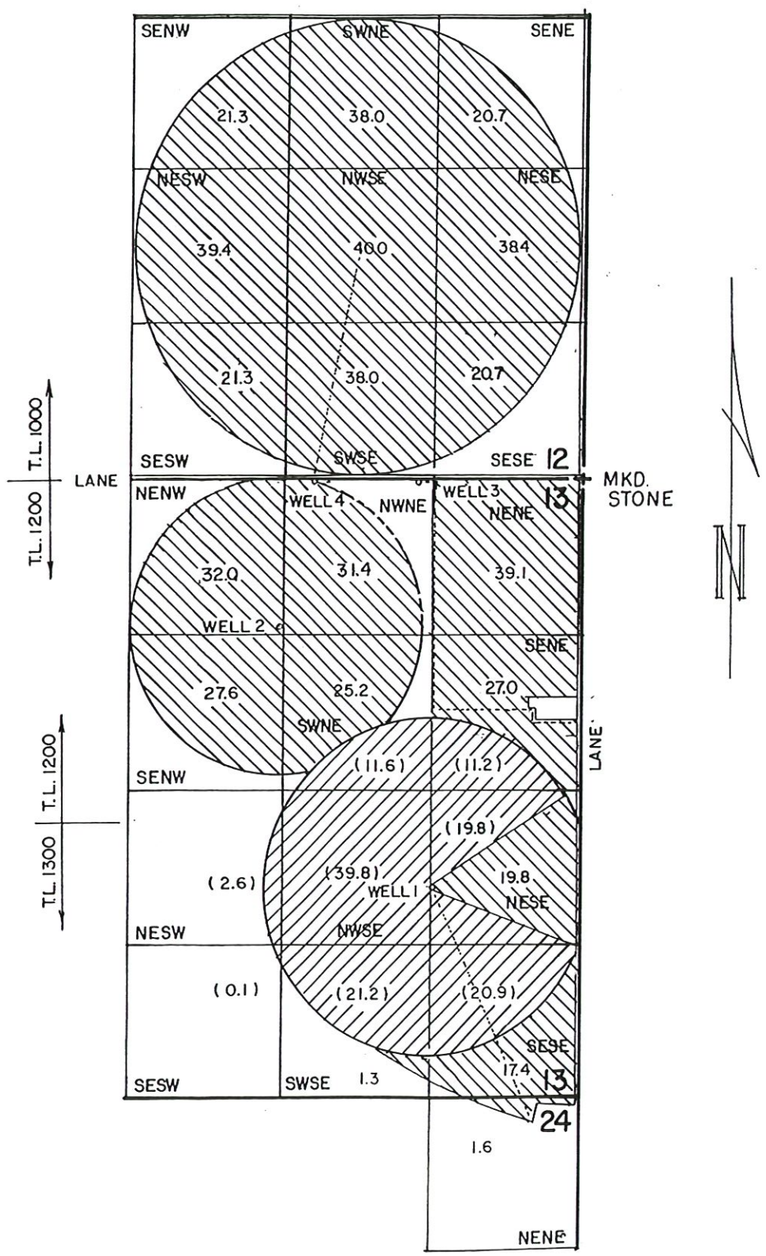

LEGEND

CERTIFICATE 61113

APPLICATION G-13295, PERMIT G-12276

WELL LOCATIONS - FROM THE N.E. CORNER OF SEC. 13.

WELL 1 3505'S, 1314'W
WELL 2 1267'S, 2688'W
WELL ~~3~~ 4 12'S, 2387'W
WELL ~~4~~ 3 15'S, 1443'W

AC/WRD 2/11/2019

THE PURPOSE OF THIS MAP IS TO IDENTIFY THE LOCATION OF THE WATER RIGHT. IT IS NOT INTENDED TO PROVIDE INFORMATION RELATIVE TO THE LOCATION OF PROPERTY OWNERSHIP.

RECEIVED
DEC 0 9 2002
WATER RESOURCES DEPT
SALEM, OREGON

Certified Water Right Examiner
#205
Clark C. Palmer
Nov. 13, 1997
STATE OF OREGON

RENEW 1-1-2003

FINAL PROOF SURVEY

UNDER
APPLICATION G-13295
PERMIT G-12276

IN THE NAME OF
FAIRVIEW ACRES DAIRY FARMS INC

Scale: 4" = 1 MILE	Date: NOV. 2002	Job: 1273-02
Dsn:	M. A. PALMER & SONS, INC. ENGINEERING & SURVEYING 254 N. Alder - Box 61 Burns, Oregon 97720	Sht. No.
Drn: CHRIS		
Ckd:		of 1