
CLAIM of BENEFICIAL USE MAP

FOR: GERALD & PENNY ANDERSON
BY: NATHAN REED, PE, CWRE
T26S, R4W, W.M. SECTION 17
APPLICATION NO. S-87685
PERMIT NO. S-54722

DATE OF SURVEY: SEPTEMBER 8, 2025

N

SCALE: 1" = 400'

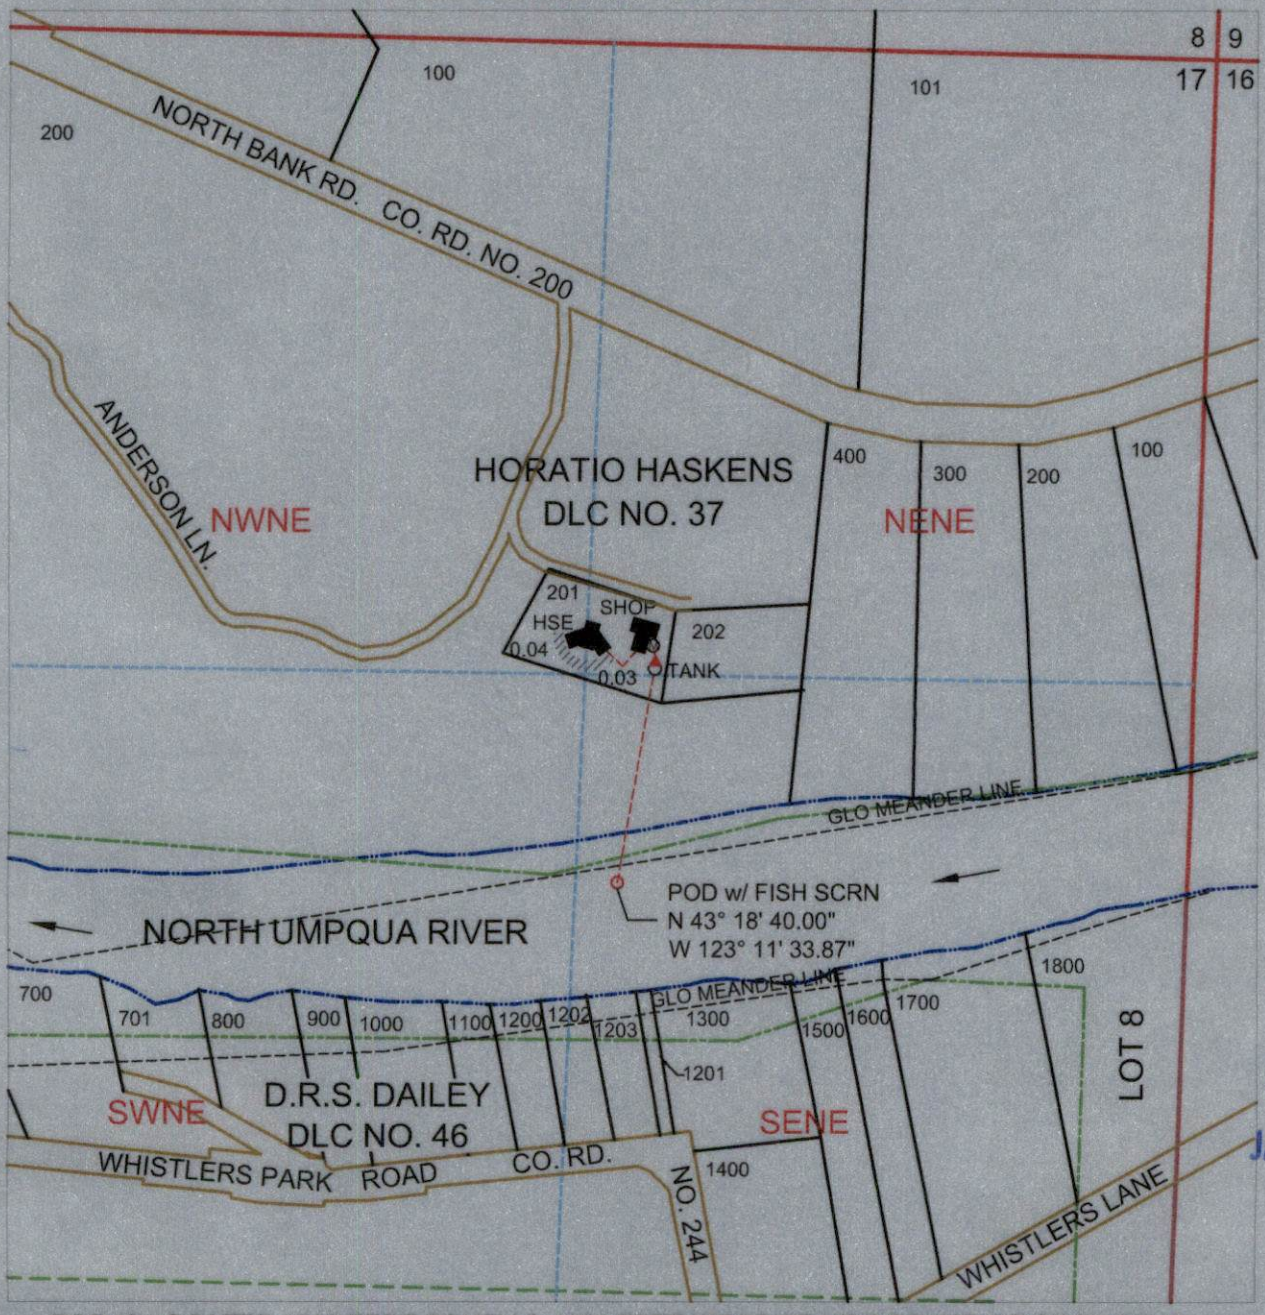

POD IS LOCATED 1707 FEET SOUTH & 1254 FEET WEST OF NE CORNER OF SECTION 17.

LEGEND

WATER	QUARTER
POD	SIXTEENTH
PUMP	DLC
METER	GLOT
TANK	PARCEL
PIPE	SECTION
MEANDER	IRRIGATION

Certified Water Right Examiner
56915
NATHAN R. REED
May 9, 2011
11-5-25
STATE OF OREGON
Expires Dec. 31, 2026

MAP PREPARED FOR:
GERALD & PENNY ANDERSON
PO BOX 1123
ROSEBURG, OR 97470

MAP PREPARED BY:
NATHAN REED PE, CWRE
157 WEST BODIE STREET
ROSEBURG, OR 97471

THE PURPOSE OF THIS MAP IS TO IDENTIFY THE LOCATION OF THE WATER RIGHT. IT IS NOT INTENDED TO PROVIDE INFORMATION RELATIVE TO THE LOCATION OF PROPERTY OWNERSHIP BOUNDARY LINES.

Received
JAN 12 2026
OWRD