LEGEND

DISCRIPTION	SYMBOLS
SECTION LINE	
QUARTER-QUARTER LINE	
TAX LOT LINE	
CREEK	
BURIED PIPE	IRR IRR
FENCE	x x x x
SECTION CORNER	36 31 / 1 6
RECOGNIZED SURVEY CORNER	
IRRIGATION PUMP	
PRIMARY WATER RIGHT AREAS	138.20 ACRES

PRIMARY WATER RIGHT PLACE OF USE (SEC., 1/4 1/4, ACRES, TAX LOT)

T.27 S. R. 36 E. SECTION 20:

(55.00 AC.)	NENE	4.00 AC.	TL700
	SENE	36.00 AC.	TL700
	SWNE	6.50 AC.	TL700
	NESE	7.00 AC.	TL403
	NWSE	1.50 AC.	TL403

T.27 S. R. 36 E. SECTION 21:

	NWNW	0.20 AC.	TL403
(15.70 AC.)	SWNW	15.00 AC.	TL403
	SESE	0.50 AC.	TL403

T.27 S. R. 36 E. SECTION 28:

	NWNW	22.00 AC.	TL1000
(41.00 AC.)	SWNW	19.00 AC.	TL1000

T.27 S. R. 36 E. SECTION 29:

	NENE	14.00 AC.	TL1000
(26.50 AC.)	SENE	12.50 AC.	TL1000

EXISTING POD LOCATIONS


POD No. 1: 1300' NORTH AND 3590' EAST OF THE NW CORNER SECTION 29, T27S., R.36 E., W.M.

POD No. 2: 1725' SOUTH AND 4580' EAST OF THE NW CORNER SECTION 29, T27S., R.36 E., W.M.

IN-LINE WATER METER LOCATIONS

METER No. 1: 65' NORTHEAST OF POD #1

METER No. 2: 9' SOUTHEAST OF POD #2

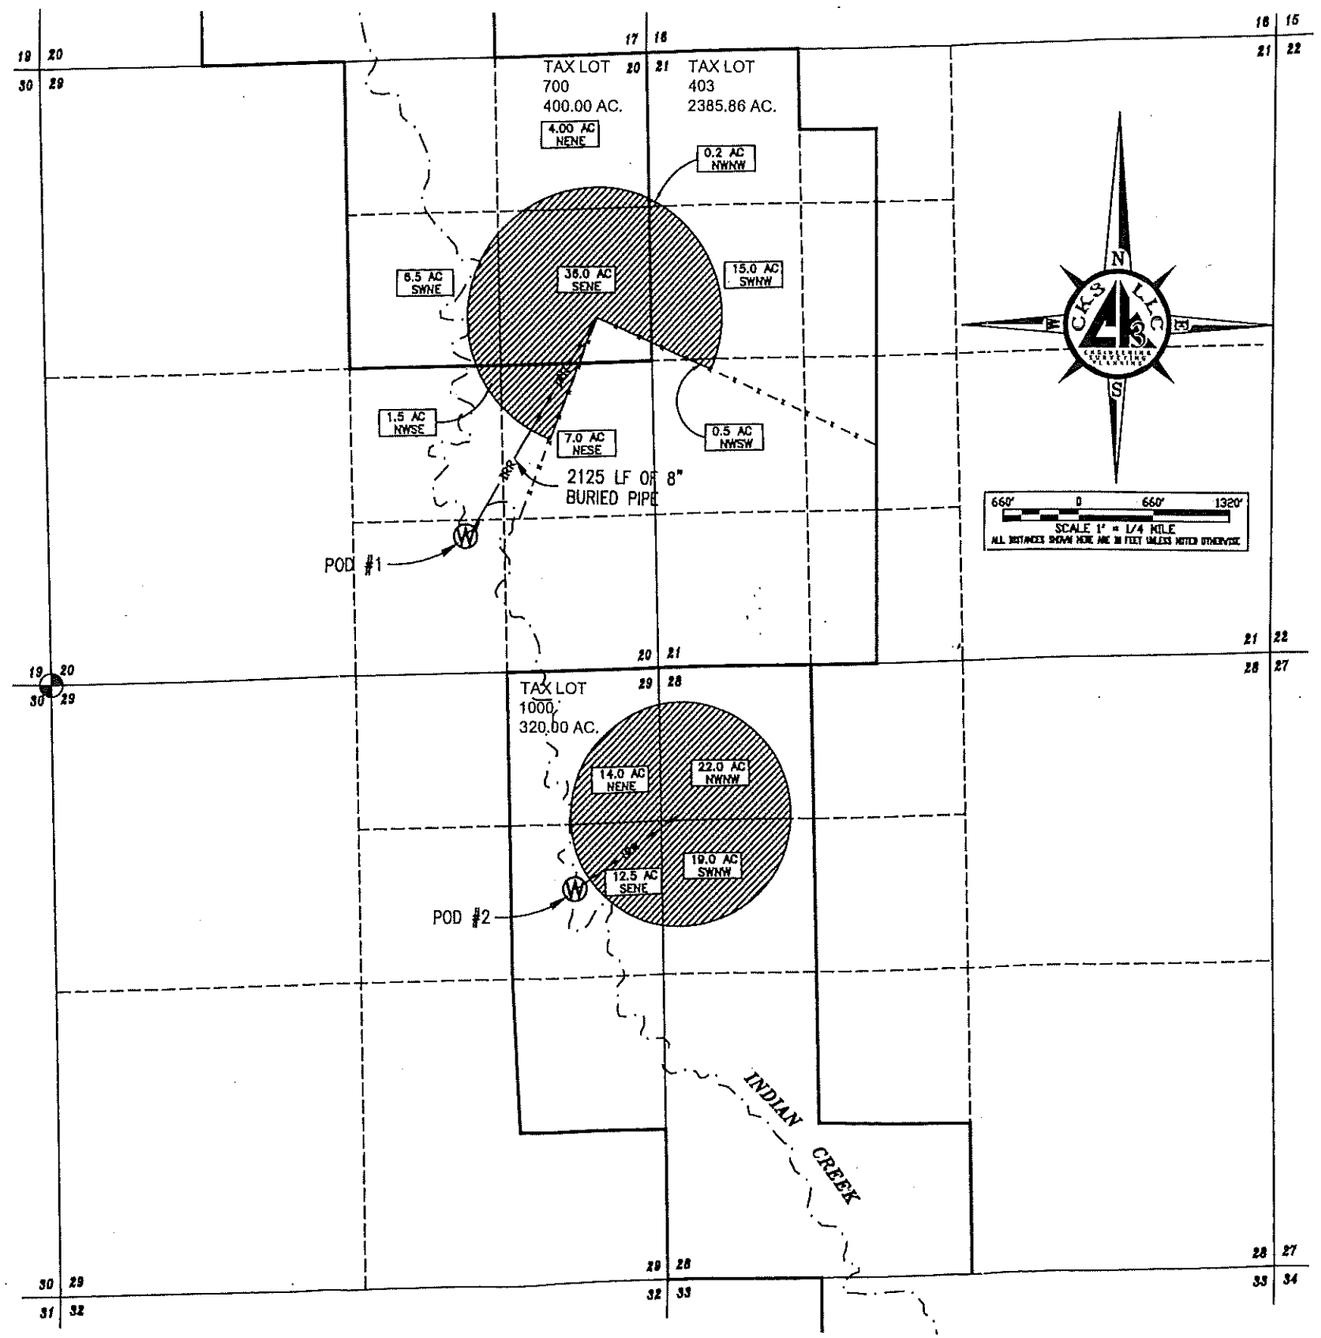

APPLICATION No.: T-6541

RECEIVED

Certified Water Right Examiner
#36234WRE
STEWART R. EDWARDS
JULY 24, 2000
STATE OF OREGON

DATE SEALED : 9·23·2011

CERTIFICATE RENEWAL : 12/31/11

DISCLAIMER

I, STEWART R. EDWARDS, HEREBY CERTIFY: THAT THIS MAP WAS MADE TO BE PART OF THE APPLICATION FOR WATER RIGHTS. SECTIONAL LINES SHOWN ARE APPROXIMATE AND THIS MAP IS NOT INTENDED FOR ANY OTHER USE AND DOES NOT GUARANTEE LAND OWNERSHIP.

COBELAC # 06237

THIS DRAWING, & ALL INFORMATION HEREIN, REMAIN THE PROPERTY OF CK3, LLC. ALL RIGHTS ARE EXPRESSLY RESERVED & IT MAY NOT BE REPRODUCED IN WHOLE OR IN PART WITHOUT THE EXPRESSED WRITTEN CONSENT OF CK3, LLC.

ENG. BY: NA
APR. BY: Stewart R. Edwards
DWG. BY: PJW
DATE: 9/22/2011

#	REVISION	DATE
01		
02		
03		
04		

CLAIM OF BENEFICIAL USE MAP
T 27 S, R 36 E,
SEC. 20, 21, 28 & 29, W.M.
HARNEY COUNTY, OREGON

TREE TOP RANCHES, LLP
P.O. BOX 8126
BOISE, ID 83707

CK3, LLC
368 S.W. 5th Avenue
Ontario, Oregon 97914
Phn: (541) 889-5411
Fax: (541) 889-2074
CIVIL–STRUCTURAL–ELECTRICAL
ENGINEERING, SURVEYING & PLANNING

WR1
SHEET: 1 OF 1
JOB: CO-11012