

**RECEIVED**  
AUG 18 1955  
STATE ENGINEER  
SEASIDE, OREGON

### Registration Statement

OF CLAIMANT OF RIGHT TO APPROPRIATE GROUND WATER

(Under Chapter 708, Oregon Laws 1955.)

TO THE STATE ENGINEER OF OREGON:

I, John H. Bigler

of Marion County of Oregon

State of Oregon, do hereby make application for a certificate of registration as evidence of a right to appropriate ground water.

1. Source from which water is withdrawn is Flowing well  
(Flowing well, pump, well, infiltration trench, or tunnel)

2. Location is: 3 miles of East of Woodburn, Marion County, Oregon  
(Approximate distance and direction from nearest city or town)

and is more particularly described as follows:

(a) 325' S. and 840' E. from N. E. corner of G. G. Townsend D. L. C.  
(Give distance and bearing to corner of section or other legal subdivision)

being within SE 1/4 of NW 1/4 of Sec. 22, Twp. 5S, Rge. 1 W. D. M.  
(Smallest legal subdivision) (N. or S.) (E. or W.)

or (b) within limits of recorded platted property, town or city:

in Lot \_\_\_\_\_, Block \_\_\_\_\_ of \_\_\_\_\_  
(Name of plat or addition)

County of \_\_\_\_\_  
(If within city or town, give name)

3. Construction Work was begun on July 10th. 1950; was completed on August 11th. 1950  
(Date) (Date)

and the ground water claimed was first used for the purposes set out below on July 12, 1950  
(Date)

since which time the water has been used continuously in season  
(Continuously or intermittently)

from July 12, 1950 to present date August 11th. 1955  
(Date) (Date)

4. Quantity of water claimed and used is \_\_\_\_\_ gallons per minute; 2 1/2 acre feet per year.

5. Purpose or Purposes for which water is used Irrigation

(Domestic, irrigation, municipal, manufacturing, industrial, etc.)

6. Description of Well: Depth 40 feet. Type Drilled  
(Dug or drilled)

diameter 6 inches. Elevation of ground at well site 170 feet, mean sea level.  
(As near as known)

Depth to water table Flowing feet.

7. Capacity of Well: \_\_\_\_\_ g.p.m. with 18 feet drawdown.  
\_\_\_\_\_ g.p.m. with \_\_\_\_\_ feet drawdown.

Date of test July 12, 1950

If Flowing Well: Measured discharge 20 g.p.m. on July 12, 1950  
(Date)

Shut-in pressure at ground surface not known lbs. per sq. in. on \_\_\_\_\_  
(Date)


Water is controlled by \_\_\_\_\_ not controlled  
(Cap, valve, etc.)

2





Township 55 Range 1W, W.M.  
North

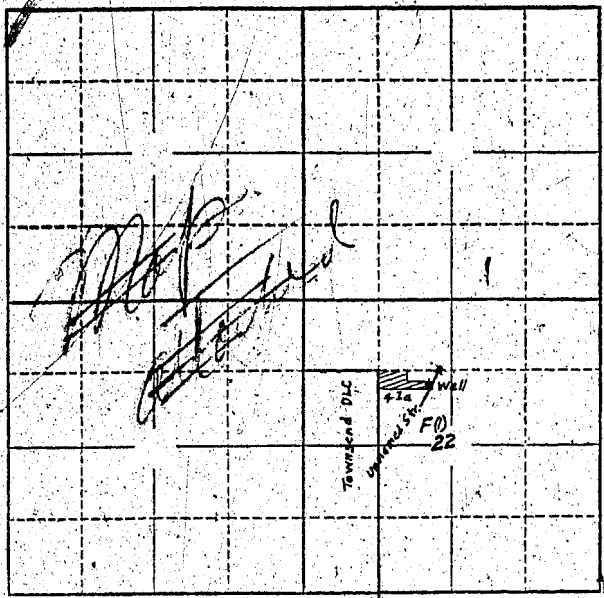

Locate well and acreage of irrigated land on plat.  
Scale: 2" = 1 Mile

STATE OF OREGON

County of Marion

SS.

I, John H. Bigler, being first duly sworn, do hereby certify that I have read the foregoing Registration Statement and that all of the items therein contained are true to the best of my knowledge and belief.

John H. Bigler  
(Signature of Registrant)

Subscribed and sworn to before me this 18 day of August, 1955.

My commission expires Sept. 22, 1958.

Wm. H. Harris  
(Notary Public)

(SEAL)

**CERTIFICATE OF REGISTRATION**

STATE OF OREGON

County of Marion

SS.

This is to certify that the foregoing Registration Statement was received in the office of the State Engineer on the 18<sup>th</sup> day of August, 1955, at 11:00 o'clock A.M. and has been duly recorded in said office, in Book No. 1 of Registration Statements on page GR-1.

Construction shall be completed by \_\_\_\_\_, 19\_\_\_\_, and the water <sup>is</sup> completely applied to beneficial use by \_\_\_\_\_, 19\_\_\_\_.

Witness my hand this 24<sup>th</sup> day of February, 1956.

Lewis A. Stanley  
(State Engineer)

By \_\_\_\_\_  
(Deputy)