

Registration Statement

OF CLAIMANT OF RIGHT TO APPROPRIATE GROUND WATER

TO THE STATE ENGINEER OF OREGON:

I, CHAS. C. HART, JR.

of Rt 1 Box 222, Jefferson County of Marion
(Mailing address)

State of Oregon, do hereby make application for a certificate of registration as evidence of a right to appropriate ground water.

1. Source from which water is withdrawn is Pump Well #3
(Flowing well, pump well, infiltration trench, or tunnel)

2. Location is: 2 1/2 Miles Southeast of Jefferson
(Approximate distance and direction from nearest city or town)

and is more particularly described as follows: 2500 feet North of 2800 feet west from SE corner Section 18

(a) E 1/2 of NW 1/4 of Sec 18
(Give distance and bearing to corner of section or other legal subdivision)

being within E 1/2 of NW 1/4 of sec 18 of Sec. 18, Twp. 10 S, Rge. 2 W
(Smallest legal subdivision) (N. or S.) (E. or W.)

or (b) within limits of recorded platted property, town or city:

in Lot _____, Block _____ of _____
(Name of plat or addition)

County of _____
(If within city or town, give name)

3. Construction Work was begun on Sept 1952; was completed on Sept 1952
(Date) (Date)

and the ground water claimed was first used for the purposes set out below on Sept 1952
(Date)

since which time the water has been used INTERMITTENTLY
(Continuously or intermittently)

from May to SEPT
(Date) (Date)

4. Quantity of water claimed and used is 250 gallons per minute; 30 acre feet per year.

5. Purpose or Purposes for which water is used irrigation

(Domestic, irrigation, municipal, manufacturing, industrial, etc.)

6. Description of Well: Depth 26 feet. Type drilled
(Dug or drilled)

diameter 8 inches. Elevation of ground at well site 244 feet, mean sea level.
(As near as known)

Depth to water table 12.2 feet.


7. Capacity of Well: 250 g.p.m. with 1.0 feet drawdown.

_____ g.p.m. with _____ feet drawdown.

Date of test _____

If Flowing Well: Measured discharge _____ g.p.m. on _____
(Date)

Township 10 S Range 2 W, W.M.
North

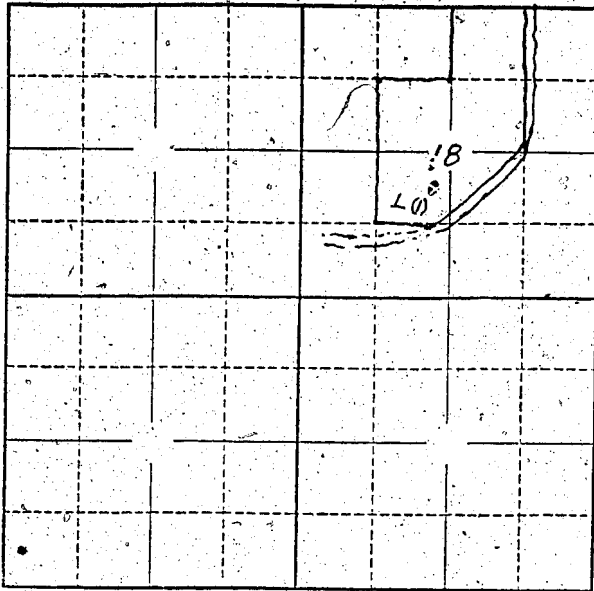

See Map in
file GR-1000

Locate well and acreage of irrigated land on plat.
Scale: 2" = 1 Mile

STATE OF OREGON

County of Marion } ss.

I, _____, being first duly sworn, do hereby certify that I have read the foregoing Registration Statement and that all of the items therein contained are true to the best of my knowledge and belief.

Chas. C. Hart, Jr.
(Signature of Registrar)

Subscribed and sworn to before me this 13th day of February, 1958

My commission expires 12th June 1961 Wm. S. Bartholomew
(Notary Public)

(SEAL)

CERTIFICATE OF REGISTRATION

STATE OF OREGON

County of Marion } ss.

This is to certify that the foregoing Registration Statement was received in the office of the State Engineer on the 13 day of February, 1958, at 10:00 o'clock A. M. and has been duly recorded in said office in Book No. 5 of Registration Statements on page 969

Witness my hand this 28 day of May, 1958

Lewis A. Standley
(State Engineer)

By _____
(Deputy)