

RECEIVED  
FEB 14 1959  
STATE ENGINEER  
SALEM, OREGON

Registration No. GR - 1015  
Certificate No. GR - 980

# Registration Statement

## OF CLAIMANT OF RIGHT TO APPROPRIATE GROUND WATER

TO THE STATE ENGINEER OF OREGON:

I, Avery Bowen and Elton Higbee

of Rt. 2, Box 369, Albany County of Linn  
(Mailing address)

State of Oregon, do hereby make application for a certificate of registration as evidence of a right to appropriate ground water.

1. Source from which water is withdrawn is Pump Well No. 1  
(Flowing well, pump well, infiltration trench, or tunnel)
2. Location is: 3 miles west of Jefferson, Oregon  
(Approximate distance and direction from nearest city or town)

and is more particularly described as follows:

(a) N. 6° 30' W. 12.25 chains from SE corner of S. 4, T. 10 S., R. 3 W.  
(Give distance and bearing to corner of section or other legal subdivision)

being within SE $\frac{1}{4}$  of SE $\frac{1}{4}$  of Sec. 4, Twp. 10 S., Rge. 3 W.  
(Smallest legal subdivision) (N. or S.) (E. or W.)

or (b) within limits of recorded platted property, town or city:

in Lot \_\_\_\_\_, Block \_\_\_\_\_ of \_\_\_\_\_  
(Name of plat or addition)  
County of Linn  
(If within city or town, give name)

3. Construction Work was begun on April 1946; was completed on April 1946  
(Date) (Date)

and the ground water claimed was first used for the purposes set out below on May 1946  
(Date)

since which time the water has been used continuously  
(Continuously or intermittently)

from May 1946 to present time  
(Date) (Date)

4. Quantity of water claimed and used is 126 gallons per minute; 23.75 acre feet per year.

5. Purpose or Purposes for which water is used Irrigation

(Domestic, irrigation, municipal, manufacturing, industrial, etc.)

6. Description of Well: Depth 22 feet. Type Drilled  
(Dug or drilled)

diameter 5 inches. Elevation of ground at well site 200 feet, mean sea level.  
(As near as known)

Depth to water table 4 feet.

7. Capacity of Well: 300 g.p.m. with 2 feet drawdown.

\_\_\_\_\_ g.p.m. with \_\_\_\_\_ feet drawdown.

Date of test May 1946

If Flowing Well: Measured discharge \_\_\_\_\_ g.p.m. on \_\_\_\_\_  
(Date)


Shut-in pressure at ground surface \_\_\_\_\_ lbs. per sq. in. on \_\_\_\_\_  
(Date)

Water is controlled by \_\_\_\_\_  
(Cap, valve, etc.)





Township 10 S Range 3 W, W.M.  
North

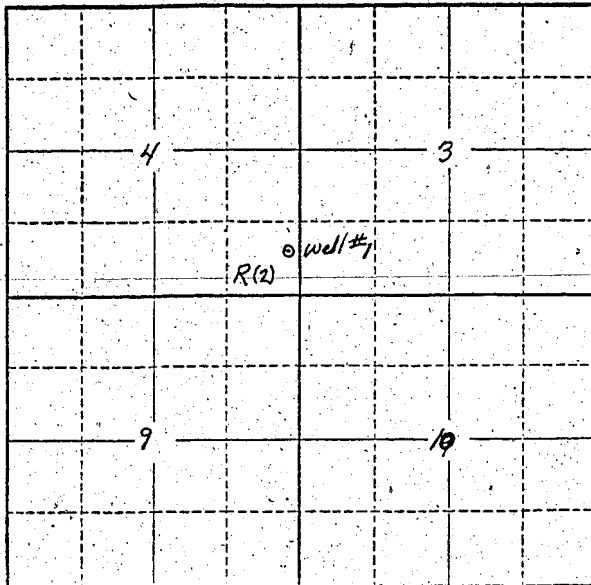

Locate well and acreage of irrigated land on plat.

Scale: 2" = 1 Mile

STATE OF OREGON

County of Marion } ss.

I, Avery Bowen and Elton Higbes, being first duly sworn, do hereby certify that I have read the foregoing Registration Statement and that all of the items therein contained are true to the best of my knowledge and belief.

Elton Higbes  
Avery Bowen  
(Signature of Registrant)

Subscribed and sworn to before me this 10th day of February, 1958.

My commission expires \_\_\_\_\_

Marion A. Hutchings  
(Notary Public)  
Notary Public for Marion District  
County of Marion, State of Oregon

(SEAL)

**CERTIFICATE OF REGISTRATION**

STATE OF OREGON } ss.  
County of Marion

This is to certify that the foregoing Registration Statement was received in the office of the State Engineer on the 14 day of February, 1958, at 8:00 o'clock A. M. and has been duly recorded in said office in Book No. 5 of Registration Statements on page 980.

Witness my hand this 28 day of May, 1958

Lewis A. Stanley  
(State Engineer)

By \_\_\_\_\_ (Deputy)