

RECEIVED
FEB 14 1953
STATE ENGINEER
SALEM, OREGON

Registration Statement

OF CLAIMANT OF RIGHT TO APPROPRIATE GROUND WATER

TO THE STATE ENGINEER OF OREGON:

I, Avery Bowen and Elton Higbee

of Rt. 2, Box 369, Albany County of Linn

(Mailing address)

State of Oregon, do hereby make application for a certificate of registration as evidence of a right to appropriate ground water.

1. Source from which water is withdrawn is Pump Well No. 2

(Flowing well, pump well, infiltration trench, or tunnel)

2. Location is: 3 miles west of Jefferson, Oregon

(Approximate distance and direction from nearest city or town)

and is more particularly described as follows:

(a) S. 1° 37' W. 15.71 chains from NE corner of SE $\frac{1}{4}$ of S. 4, T. 10 S., R. 3 W.

(Give distance and bearing to corner of section or other legal subdivision)

being within NE $\frac{1}{4}$ of SE $\frac{1}{4}$ of Sec. 4, Twp. 10 S Rge. 3 W

(Smallest legal subdivision)

(N. or S.)

(E. or W.)

or (b) within limits of recorded platted property, town or city:

in Lot _____, Block _____ of _____

(Name of plat or addition)

County of Linn

(If within city or town, give name)

3. Construction Work was begun on May 1952, was completed on May 1952

(Date)

(Date)

and the ground water claimed was first used for the purposes set out below on May 1952

(Date)

since which time the water has been used continuously

(Continuously or intermittently)

from May 1952 to present time

(Date)

(Date)

4. Quantity of water claimed and used is 175 gallons per minute; 46.25 acre feet per year.

5. Purpose or Purposes for which water is used Irrigation

(Domestic, irrigation, municipal, manufacturing, industrial, etc.)

6. Description of Well: Depth 25 feet. Type Drilled

(Dug or drilled)

diameter 8 inches. Elevation of ground at well site 205 feet, mean sea level.

(As near as known)

Depth to water table 9 feet.

7. Capacity of Well: 400 g.p.m. with 1 feet drawdown.

 g.p.m. with feet drawdown.

Date of test May

If Flowing Well: Measured discharge g.p.m. on

(Date)

Shut-in pressure at ground surface lbs. per sq. in. on

(Date)

Water is controlled by

(Cap, valve, etc.)

8. **Casing:** (Give diameter, commercial specifications and depth below ground surface of each casing size.)

8 inch diameter steel casing from 0 to 25 feet
inch diameter from to feet
inch diameter from to feet
inch diameter from to feet

Describe and show depth of shoe, plug, adapter, liner or other details:

9. **Perforated Casings or Screens:**

Slot perforations from 17 to 25 feet
(Number per foot and size of perforations, or describe screen)
from to feet
from to feet
from to feet

10. **Log of Well:** (Describe each stratum or formation clearly, indicate if water bearing, and give thickness and depth as indicated.)

MATERIAL	Thickness (Feet)	Depth to Bottom (Feet)
Not available		

If log of well is not available, give name and address of driller. Bill Hamilton Drilling Co.,
838 East Third Avenue, Albany, Oregon

11. Infiltration Trench: Covered or open
 Dimensions: Length ft. Minimum depth ft. Maximum depth ft.
 Bottom width ft. Discharge g.p.m. Date of test

12. Tunnel: Type of lining
 Dimensions:
(Length, course, and cross sectional size)
 Position of water bearing stratum with reference to portal of tunnel

Log of tunnel: (Preceding table for log of well may be used, if desired. Give footage from portal and character of materials, as pertinent.)


13. Pumping Equipment:
 (a) Pump 2" centrifugal Capacity 300 g.p.m.
(Make, type and size)
 (b) Motor 10 H. P. electric
(Type and horsepower)

14. Location of area irrigated or to be irrigated, or place of use if for purposes other than irrigation.

Township North or South	Range E. or W. of Willamette Meridian	Section	Forty-acre Tract	Number Acres To Be Irrigated	Date of Reclamation
10 S	3 W	4	NE $\frac{1}{4}$ of SE $\frac{1}{4}$	11.0	May 1952
10 S	3 W	4	SE $\frac{1}{4}$ of SE $\frac{1}{4}$	4.5	May 1952
				18.5	

15. If the ground water supply is supplemental to an existing water supply, identification of any application for a permit, permit, certificate or adjudicated right to appropriate water made or held by the registrant.

Township 10 S Range 3 W, W.M.
North

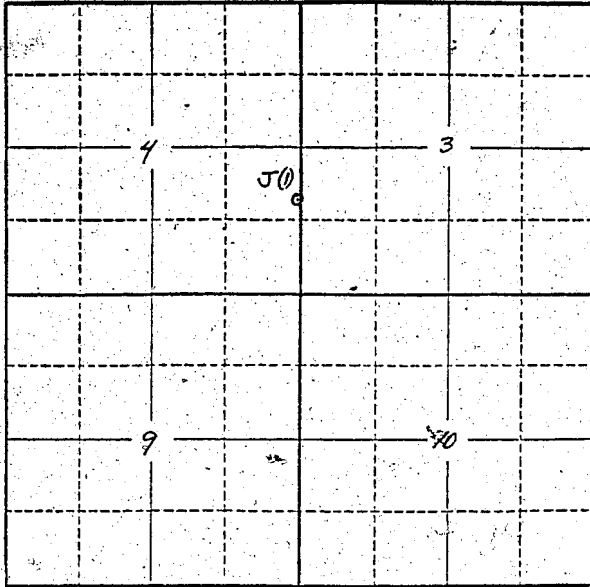

Locate well and acreage of irrigated land on plat.
Scale: 2" = 1 Mile

STATE OF OREGON

County of Marion } ss.

I, Avery Bowen and Elton Higbee, being first duly sworn, do hereby certify that I have read the foregoing Registration Statement and that all of the items therein contained are true to the best of my knowledge and belief.

Elton Higbee

Avery Bowen

(Signature of Registrant)

Subscribed and sworn to before me this 10th day of February, 1958

My commission expires

Glenn A. Theberge

Notary Public
Judge of the Peace for the District
County of Marion, State of Oregon

(SEAL)

CERTIFICATE OF REGISTRATION

STATE OF OREGON

County of Marion } ss.

This is to certify that the foregoing Registration Statement was received in the office of the State Engineer on the 14th day of February, 1958, at 5:00 o'clock A. M. and has been duly recorded in said office in Book No. 5 of Registration Statements on page 281

Witness my hand this 28 day of May, 1958

Lewis A. Stanley
(State Engineer)

By

(Deputy)

GR-981 C