

Registration Statement

OF CLAIMANT OF RIGHT TO APPROPRIATE GROUND WATER

TO THE STATE ENGINEER OF OREGON:

I, D. L. Cook

of Rt. 2, Box 337, Albany

County of Linn

State of Oregon

, do hereby make application for a certificate of registration as evidence of a right to appropriate ground water.

1. Source from which water is withdrawn is Pump Well No. 1

(Flowing well, pump well, infiltration trench, or tunnel)

2. Location is: 7 miles SW of Jefferson, Oregon

(Approximate distance and direction from nearest city or town)

and is more particularly described as follows:

(a) S. 48° W. 14.75 chains from NW corner of DIC 72, T. 10 S., R. 3 W.

(Give distance and bearing to corner of section or other legal subdivision)

being within NW 1/4 of SW 1/4

(Smallest legal subdivision)

of Sec. 6

Twp. 10 S.

Rge. 3 W.

(E. or W.)

or (b) within limits of recorded platted property, town or city:

in Lot _____, Block _____ of _____

(Name of plat or addition)

County of Linn

(If within city or town, give name)

3. Construction Work was begun on 1948

(Date)

; was completed on 1948

(Date)

and the ground water claimed was first used for the purposes set out below on 1948

(Date)

since which time the water has been used continuously

(Continuously or intermittently)

from 1948 to present time

(Date)

(Date)

4. Quantity of water claimed and used is 462 gallons per minute; 159.5 acre

feet per year.

5. Purpose or Purposes for which water is used Irrigation

(Domestic, irrigation, municipal, manufacturing, industrial, etc.)

6. Description of Well: Depth 35 feet. Type Drilled

(Dug or drilled)

diameter 12 inches. Elevation of ground at well site 180 feet, mean sea level.

(As near as known)

Depth to water table 12 feet.

7. Capacity of Well: 500 g.p.m. with 10 feet drawdown.

_____ g.p.m. with _____ feet drawdown.

Date of test Estimated - not tested

If Flowing Well: Measured discharge _____ g.p.m. on _____

(Date)


Shut-in pressure at ground surface _____ lbs. per sq. in. on _____

(Date)

Water is controlled by _____

(Cap, valve, etc.)

Township 10 S Range 3 W, W.M.
North

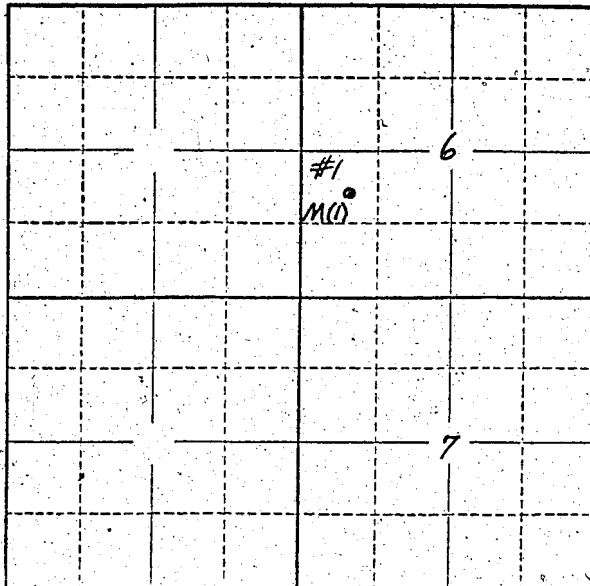

Locate well and acreage of irrigated land on plat.
Scale: 2" = 1 Mile

STATE OF OREGON

County of Linn

} ss.

I, D. L. Cook, being first duly sworn, do hereby certify that I have read the foregoing Registration Statement and that all of the items therein contained are true to the best of my knowledge and belief.

D. L. Cook
.....
(Signature of Registrant)

Subscribed and sworn to before me this 13th day of February, 1958.

My commission expires COMMISSION EXPIRES DEC. 4, 1958

James [unclear]
.....
(Notary Public)

(SEAL)

CERTIFICATE OF REGISTRATION

STATE OF OREGON

County of Marion

} ss.

This is to certify that the foregoing Registration Statement was received in the office of the State Engineer on the 12 day of February, 1958, at 9:00 o'clock A. M. and has been duly recorded in said office in Book No. 5 of Registration Statements on page 981.

Witness my hand this 28 day of May, 1958.

Lewis A. Stanley
.....
(State Engineer)

By _____
(Deputy)

GR - 984 C