

# Registration Statement

## OF CLAIMANT OF RIGHT TO APPROPRIATE GROUND WATER

**TO THE STATE ENGINEER OF OREGON:**

I, M. C. and/or Pearl Helma  
of Route 1, Jefferson County of Linn  
(Mailing address)  
State of Oregon, do hereby make application for a certificate of registration as evidence of a right to appropriate ground water.

1. Source from which water is withdrawn is pump well No. 10  
(Flowing well, pump well, infiltration trench, or tunnel)
2. Location is: 5 miles SE of Jefferson, Oregon  
(Approximate distance and direction from nearest city or town)

and is more particularly described as follows:

(a) S. 26°20' E. 36 chains from NW corner of SW $\frac{1}{4}$  of S. 19, T 10S, R. 2W  
(Give distance and bearing to corner of section or other legal subdivision)  
being within SW $\frac{1}{4}$  of SW $\frac{1}{4}$  of Sec. 19, Twp. 10S, Rge. 2W  
(Smallest legal subdivision) (N. or S.) (E. or W.)  
or (b) within limits of recorded platted property, town or city:  
in Lot \_\_\_\_\_, Block \_\_\_\_\_ of \_\_\_\_\_  
(Name of plat or addition)  
County of Linn  
(If within city or town, give name)

3. Construction Work was begun on 1951; was completed on 1951  
(Date) (Date)  
and the ground water claimed was first used for the purposes set out below on 1951  
(Date)  
since which time the water has been used continuously  
(Continuously or intermittently)  
from 1951 to present time  
(Date) (Date)

4. Quantity of water claimed and used is 300 gallons per minute; 53.0 acre feet per year.

5. Purpose or Purposes for which water is used Irrigation  
(Domestic, irrigation, municipal, manufacturing, industrial, etc.)

6. Description of Well: Depth 20 feet. Type drilled  
(Dug or drilled)  
diameter 8 inches. Elevation of ground at well site 225 feet, mean sea level.  
(As near as known)  
Depth to water table 5 feet.

7. Capacity of Well: 650 g.p.m. with 8 feet drawdown.  
\_\_\_\_\_ g.p.m. with \_\_\_\_\_ feet drawdown.

Date of test 1951

If Flowing Well: Measured discharge \_\_\_\_\_ g.p.m. on \_\_\_\_\_  
(Date)

Shut-in pressure at ground surface \_\_\_\_\_ lbs. per sq. in. on \_\_\_\_\_  
(Date)

Water is controlled by \_\_\_\_\_  
(Cap, valve, etc.)

8. **Casing:** (Give diameter, commercial specifications and depth below ground surface of each casing size.)

8 inch diameter steel casing from 0 to 20 feet  
 \_\_\_\_\_ inch diameter \_\_\_\_\_ from \_\_\_\_\_ to \_\_\_\_\_ feet  
 \_\_\_\_\_ inch diameter \_\_\_\_\_ from \_\_\_\_\_ to \_\_\_\_\_ feet  
 \_\_\_\_\_ inch diameter \_\_\_\_\_ from \_\_\_\_\_ to \_\_\_\_\_ feet

Describe and show depth of shoe, plug, adapter, liner or other details: \_\_\_\_\_  
 \_\_\_\_\_  
 \_\_\_\_\_

9. **Perforated Casings or Screens:**

slot perforations # \_\_\_\_\_ from 8 to 20  
(Number per foot and size of perforations, or describe screen)  
 \_\_\_\_\_ from \_\_\_\_\_ to \_\_\_\_\_  
 \_\_\_\_\_ from \_\_\_\_\_ to \_\_\_\_\_  
 \_\_\_\_\_ from \_\_\_\_\_ to \_\_\_\_\_

10. **Log of Well:** (Describe each stratum or formation clearly, indicate if water bearing, and give thickness and depth as indicated.)

MATERIAL	Thickness (Feet)	Depth to Bottom (Feet)
Not available		

If log of well is not available, give name and address of driller. Marion West, Salem, Oregon

11. Infiltration Trench: Covered or open .....  
Dimensions: Length ..... ft. Minimum depth ..... ft. Maximum depth ..... ft.  
Bottom width ..... ft. Discharge ..... g.p.m. Date of test .....

12. Tunnel: Type of lining .....  
Dimensions: .....  
(Length, course, and cross sectional size)  
Position of water bearing stratum with reference to portal of tunnel .....

Log of tunnel: (Preceding table for log of well may be used, if desired. Give footage from portal and character of materials, as pertinent.)


13. Pumping Equipment:  
(a) Pump Fairbanks Morse 3" centrifugal ..... Capacity 300 ..... g.p.m.  
(Make, type and size)  
(b) Motor 15 HP electric .....  
(Type and horsepower)

14. Location of area irrigated or to be irrigated, or place of use if for purposes other than irrigation.

Township North or South	Range E. or W. of Willamette Meridian	Section	Forty-acre Tract	Number Acres To Be Irrigated	Date of Reclamation
10S	2W	19	SW $\frac{1}{4}$ of SW $\frac{1}{4}$	20.0	1951
10S	2W	19	NW $\frac{1}{4}$ of SW $\frac{1}{4}$	1.2	1951
				21.2	

15. If the ground water supply is supplemental to an existing water supply, identification of any application for a permit, permit, certificate or adjudicated right to appropriate water made or held by the registrant.

Township 10S Range 2W W.M.  
North

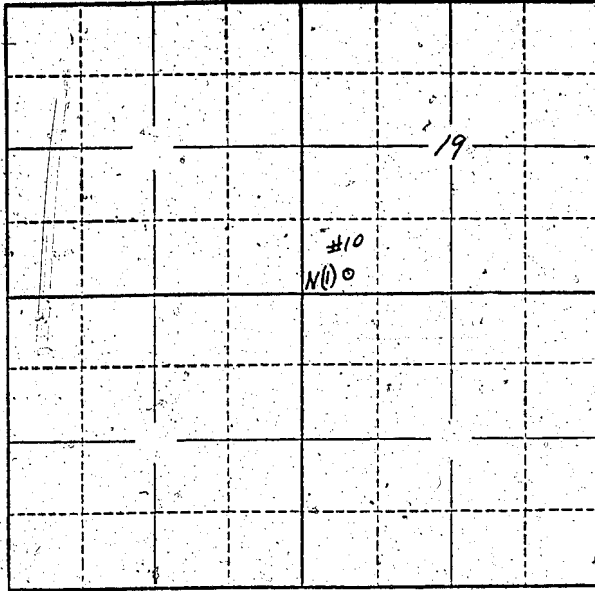

Locate well and acreage of irrigated land on plat.  
Scale: 2" = 1 Mile

STATE OF OREGON

County of Marion } ss.

I, M. C. and/or Pearl Helms, being first duly sworn, do hereby certify that I have read the foregoing Registration Statement and that all of the items therein contained are true to the best of my knowledge and belief.

*Pearl Helms*  
(Signature of Registrant)

Subscribed and sworn to before me this 11th day of February, 1958

My commission expires \_\_\_\_\_  
(SEAL)

*W. A. [Signature]*  
(Notary Public)  
Justice of the Peace, Oregon District  
Marion County, Oregon

**CERTIFICATE OF REGISTRATION**

STATE OF OREGON } ss.  
County of Marion

This is to certify that the foregoing Registration Statement was received in the office of the State Engineer on the 17th day of February, 1958, at 8:00 o'clock A.M. and has been duly recorded in said office in Book No. 5 of Registration Statements on page 998.

Witness my hand this 28 day of May, 1958.

*Lewis A. Stanley*  
(State Engineer)

By \_\_\_\_\_  
(Deputy)