

RECEIVED
MAY 1952
STATE ENGINEER
CLACKAMAS COUNTY

REGISTRATION NO. GR-104
CERTIFICATE NO. GR-96

Registration Statement

OF CLAIMANT OF RIGHT TO APPROPRIATE GROUND WATER

(Under Chapter 708, Oregon Laws 1955.)

TO THE STATE ENGINEER OF OREGON:

I, LEWIS ISAACS

of Rt. 1, Box 279, Clackamas County of Clackamas

State of OREGON, do hereby make application for a certificate of registration as evidence of a right to appropriate ground water.

1. Source from which water is withdrawn is Pump Well
(Flowing well, pump well, infiltration trench, or tunnel)

2. Location is: X
(Approximate distance and direction from nearest city or town)

and is more particularly described as follows:

(a) S 50° 10' E, 2660 Feet from the NW Corner Sec. 6
(Give distance and bearing to corner of section or other legal subdivision)

being within SE 1/4 of NW 1/4 of Sec. 6, Twp. 2S, Rge. 3E
(Smallest legal subdivision) (N. or S.) (E. or W.)

or (b) within limits of recorded platted property, town or city:

in Lot _____, Block _____ of _____
(Name of plat or addition)

County of _____
(If within city or town, give name)

3. Construction Work was begun on MARCH 1952; was completed on April - 1952
(Date) (Date)

and the ground water claimed was first used for the purposes set out below on AUGUST - 1953
(Date)

since which time the water has been used INTERMITTENTLY throughout the summer
(Continuously or Intermittently)

from AUGUST - 1953 DATE _____
(Date) (Date)

4. Quantity of water claimed and used is 112 gallons per minute; Approx 2 acre feet per year per acre

5. Purpose or Purposes for which water is used IRRIGATION

(Domestic, irrigation, municipal, manufacturing, industrial, etc.)

6. Description of Well: Depth 227 feet. Type Drilled
(Dug or drilled)

diameter 8" inches. Elevation of ground at well site 340 feet feet, mean sea level.
(As near as known)

Depth to water table 75 feet.

7. Capacity of Well: 105 g.p.m. with 116 feet drawdown.

_____ g.p.m. with _____ feet drawdown.

Date of test April - 1952

If Flowing Well: Measured discharge _____ g.p.m. on _____
(Date)

Shut-in pressure at ground surface _____ lbs. per sq. in. on _____
(Date)

Water is controlled by _____
(Cap, valve, etc.)

8. Casing: (Give diameter, commercial specifications and depth below ground surface of each casing size.)

8 inch diameter from Surface to 227 feet
 inch diameter from to feet
 inch diameter from to feet
 inch diameter from to feet

Describe and show depth of shoe, plug, adapter, liner or other details:

9. Perforated Casings or Screens:

no record from to
(Number per foot and size of perforations, or describe screen)
 from to
 from to
 from to

10. Log of Well: (Describe each stratum or formation clearly, indicate if water bearing, and give thickness and depth as indicated.)

MATERIAL	Thickness (Feet)	Depth to Bottom (Feet)
CLAY	20	20
CEMENT GRAVEL	60	80
SOLID ROCK	35	115
RED CLAY	5	125
BLUE CLAY	5	125
SAUD	5	130
CEMENT GRAVEL	80	210
LOOSE GRAVEL	17	227

If log of well is not available, give name and address of driller: _____

O. B. OLSEN - BORING, OREGON

11. Infiltration Trench: Covered or open _____

Dimensions: Length _____ ft. Minimum depth _____ ft. Maximum depth _____ ft.

Bottom width _____ ft. Discharge _____ g.p.m. Date of test _____

12. Tunnel: Type of lining _____

Dimensions: _____
(Length, course, and cross sectional size)

Position of water bearing stratum with reference to portal of tunnel _____

Log of tunnel: (Preceding table for log of well may be used, if desired. Give footage from portal and character of materials, as pertinent.)

13. Pumping Equipment:

(a) Pump JACUZZI 10 H.P. - TURBINE - 4" Discharge Capacity 120 g.p.m.
(Make, type and size)


(b) Motor General ELECTRIC - 3 PHASE - 10 HORSE POWER
(Type and horsepower)

14. Location of area irrigated or to be irrigated, or place of use if for purposes other than irrigation.

Township North or South	Range E. or W. of Willamette Meridian	Section	Forty-acre Tract	Number Acres To Be Irrigated	Date of Reclamation
2S	3E	6	SE 1/4 NW 1/4	9.6	August 1953
2S	3E	6	SW 1/4 NW 1/4	3.3	"

15. If the ground water supply is supplemental to an existing water supply, identification of any application for a permit, permit, certificate or adjudicated right to appropriate water made or held by the registrant.

Township 2S Range 3E W.M.
North

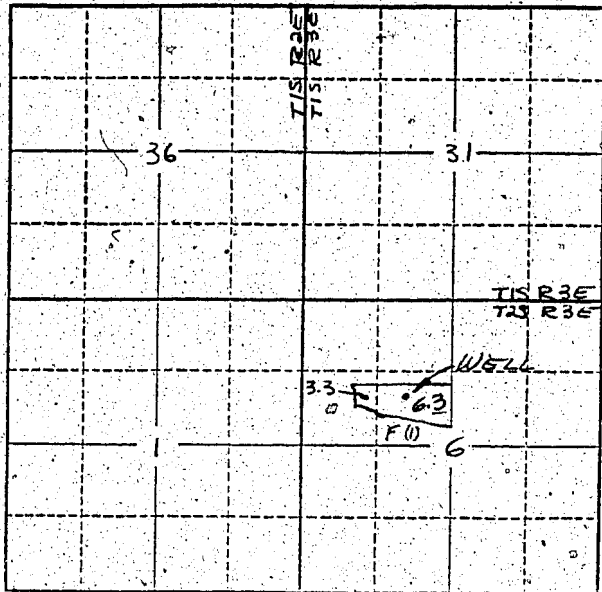

Locate well and acreage of irrigated land on plat.

Scale: 2" = 1 Mile

STATE OF OREGON

County of MULTNOMAH } ss.

I, LEVIN ISAACS, being first duly sworn, do hereby certify that I have read the foregoing Registration Statement and that all of the items therein contained are true to the best of my knowledge and belief.

X Levin Isaac
(Signature of Registrant)

Subscribed and sworn to before me this 1 day of FEBRUARY, 19 56

My commission expires O. L. Westbrook
(Notary Public)

(SEAL)

CERTIFICATE OF REGISTRATION

STATE OF OREGON

County of Marion } ss.

This is to certify that the foregoing Registration Statement was received in the office of the State Engineer on the 7th day of February, 19 56, at 8:00 o'clock A. M. and has been duly recorded in said office in Book No. 1 of Registration Statements on page GR-96C

~~Conservation of water is the duty of every citizen and the water is to be used for the benefit of the people of the State.~~

Witness my hand this 12th day of April, 19 56

Levin A. Stanley
(State Engineer)

By _____
(Deputy)

GR-96 C