

Registration Statement

OF CLAIMANT OF RIGHT TO APPROPRIATE GROUND WATER

TO THE STATE ENGINEER OF OREGON:

I, Walter Pinehart
 of Rt 1 Box 481 Warren Oregon county of Columbia
(Mailing address)
 State of Oregon, do hereby make application for a certificate of registration as evidence
 of a right to appropriate ground water.

1. Source from which water is withdrawn is Pump Well
(Flowing well, pump well, infiltration trench, or tunnel)

2. Location is: Two miles south of St Helens
(Approximate distance and direction from nearest city or town)

and is more particularly described as follows: 400 feet north & 180 feet west from SE corner Section 7

(a) Part 2 of Tract 5 Mountain View 3.54 Acres
(Give distance and bearing to corner of section or other legal subdivision)

being within ~~XXXXXX~~ of Sec. 17, Twp. 4, Rge. 1 W
(Smallest legal subdivision) (N. or S.) (E. or W.)

or (b) within limits of recorded platted property, town or city:

in Lot _____, Block _____ of _____
(Name of plat or addition)

County of _____
(If within city or town, give name)

3. Construction Work was begun on July 1954; was completed on July 54
(Date) (Date)

and the ground water claimed was first used for the purposes set out below on April 1955
(Date)

since which time the water has been used Every day
(Continuously or intermittently)

from April to Oct
(Date) (Date)

4. Quantity of water claimed and used is Ten gallons per minute; _____ acre
 feet per year.

5. Purpose or Purposes for which water is used ~~Domestic~~ irrigation
(Domestic, irrigation, municipal, manufacturing, industrial, etc.)

6. Description of Well: Depth 69 feet. Type Drilled
(Dug or drilled)

diameter 6 inches. Elevation of ground at well site ~~##~~ 100 feet, mean sea level.
(As near as known)

Depth to water table 60 feet.

7. Capacity of Well: 12 g.p.m. with 6 feet drawdown.

_____ g.p.m. with _____ feet drawdown.

Date of test July 1954

If Flowing Well: Measured discharge _____ g.p.m. on _____
(Date)

Shut-in pressure at ground surface _____ lbs. per sq. in. on _____
(Date)

Water is controlled by _____
(Cap, valve, etc.)

8. Casing: (Give diameter, commercial specifications and depth below ground surface of each casing size.)

6 inch diameter *Steel* from *Surface* to *69* feet
 inch diameter from to feet
 inch diameter from to feet
 inch diameter from to feet

Describe and show depth of shoe, plug, adapter, liner or other details:

9. Perforated Casings or Screens:

..... from to
(Number per foot and size of perforations, or describe screen)
 from to
 from to
 from to

10. Log of Well: (Describe each stratum or formation clearly, indicate if water bearing, and give thickness and depth as indicated.)

MATERIAL	Thickness (Feet)	Depth to Bottom (Feet)
<i>Top Soil</i>	<i>No Water</i>	<i>2</i>
<i>Clay</i>	<i>No water</i>	<i>58</i>
<i>Sand</i>	<i>Water</i>	<i>9</i>

If log of well is not available, give name and address of driller.

11. Infiltration Trench: Covered or open
 Dimensions: Length ft. Minimum depth ft. Maximum depth ft.

Bottom width ft. Discharge g.p.m. Date of test

12. Tunnel: Type of lining

Dimensions:
(Length, course, and cross sectional size)

Position of water bearing stratum with reference to portal of tunnel

Log of tunnel: (Preceding table for log of well may be used, if desired. Give footage from portal and character of materials, as pertinent.)

13. Pumping Equipment:

(a) Pump *Myers 3/4 Hp* Capacity *10* g.p.m.
(Make, type and size)


(b) Motor *?*
(Type and horsepower)

14. Location of area irrigated or to be irrigated, or place of use if for purposes other than irrigation.

Township North or South	Range E. or W. of Willamette Meridian	Section	Forty-acre Tract	Number Acres To Be Irrigated	Date of Reclamation
<i>Part 2</i>	<i>Tract 5</i>	<i>Mountain View</i>		<i>3.54</i>	
<i>4N</i>	<i>1W</i>	<i>7</i>	<i>SE 1/4</i>		
<i>4N</i>	<i>1W</i>	<i>7</i>	<i>SE 1/4 of SE 1/4</i>	<i>3.54</i>	<i>April 1956</i>

15. If the ground water supply is supplemental to an existing water supply, identification of any application for a permit, permit, certificate or adjudicated right to appropriate water made or held by the registrant.

Township 4N Range 1W W.M.
North

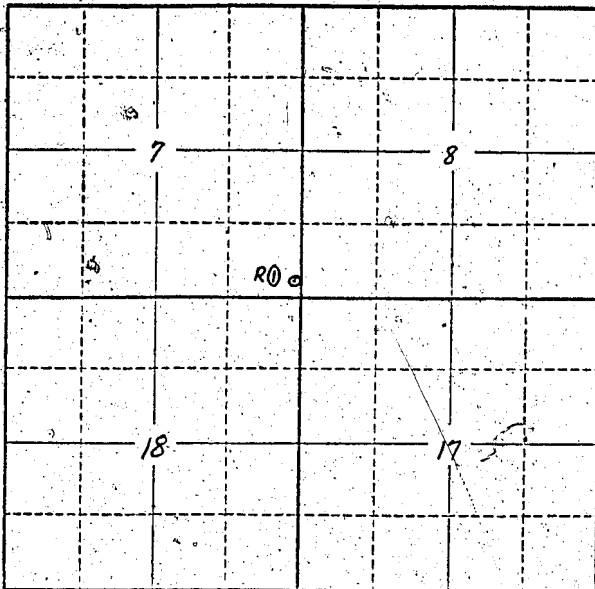

Locate well and acreage of irrigated land on plat.

Scale: 2" = 1 Mile

STATE OF OREGON

County of Columbia } ss.

I, Walter Rinehart, being first duly sworn, do hereby certify that I have read the foregoing Registration Statement and that all of the items therein contained are true to the best of my knowledge and belief.

Walter Rinehart
(Signature of Registrant)

Subscribed and sworn to before me this 13th day of February, 1958.

My commission expires Nov. 4, 1960.

Marie Walker Poff
for Oregon (Notary Public)

(SEAL)

CERTIFICATE OF REGISTRATION

STATE OF OREGON } ss.
County of Marion

This is to certify that the foregoing Registration Statement was received in the office of the State Engineer on the 17 day of February, 1958, at 6 o'clock A. M. and has been duly recorded in said office in Book No. 5 of Registration Statements on page 1003.

Witness my hand this 28 day of May, 1958

Laura A. Stankin
(State Engineer)

By _____ (Deputy)