

RECEIVED

STATE ENGINEER
SALEM, OREGON

Registration Statement

REGISTRATION NO. GR-1041
CERTIFICATE NO. GR-1004

OF CLAIMANT OF RIGHT TO APPROPRIATE GROUND WATER

(Under Chapter 708, Oregon Laws 1955.)

TO THE STATE ENGINEER OF OREGON:

I, Velma M. Forca
of Salem County of Marion
State of Oregon, do hereby make application for a certificate of registration as evidence of a right to appropriate ground water.

1. Source from which water is withdrawn is Pump Well
(Flowing well, pump well, infiltration trench, or tunnel)
2. Location is: 5 miles East Salem Ore
(Approximate distance and direction from nearest city or town)

and is more particularly described as follows:

- (a) 1800 feet west and 120 feet south from NE corner Section 33
(Give distance and bearing to corner of section or other legal subdivision)
- being within NW 1/4 of NE 1/4 of Sec. 33, Twp. 7 S, Rge. 2 W
(Smallest legal subdivision) (N or S) (E or W)
- or (b) within limits of recorded platted property, town or city: _____
- in Lot _____, Block _____ of _____
(Name of plat or addition)

(If within city or town, give name)

3. Construction Work was begun on Prior to 1946; was completed on 1946
(Date) (Date)
- and the ground water claimed was first used for the purposes set out below on 1950
(Date)
- since which time the water has been used Continuously
(Continuously or Intermittently)
- from 1950 to 8-3-56
(Date) (Date)

4. Quantity of water claimed and used is 60 gallons per minute; _____ acre feet per year.

5. Purpose or Purposes for which water is used Irrigation

(Domestic, irrigation, municipal, manufacturing, industrial, etc.)

6. Description of Well: Depth 93 feet. Type Drilled
(Dug or drilled)
- diameter 6 inches. Elevation of ground at well site 220 feet, mean sea level.
(As near as known)
- Depth to water table 36 feet.

7. Capacity of Well: 55 g.p.m. with 62 feet drawdown.
_____ g.p.m. with _____ feet drawdown.

Date of test August 54

If Flowing Well: Measured discharge _____ g.p.m. on _____
(Date)

Shut-in pressure at ground surface _____ lbs. per sq. in. on _____
(Date)

Water is controlled by _____
(Cap, valve, etc.)

6 inch diameter steel casing from Top to 90 feet

inch diameter _____ from _____ to _____ feet

inch diameter _____ from _____ to _____ feet


inch diameter _____ from _____ to _____ feet

unk. _____ from _____ to _____
(Number per foot and size of perforations, or describe screen)
_____ from _____ to _____
_____ from _____ to _____
_____ from _____ to _____

[illegible]

24.96 Acres
Sec 28+33

Township 7S Range 2W, W.M.
North

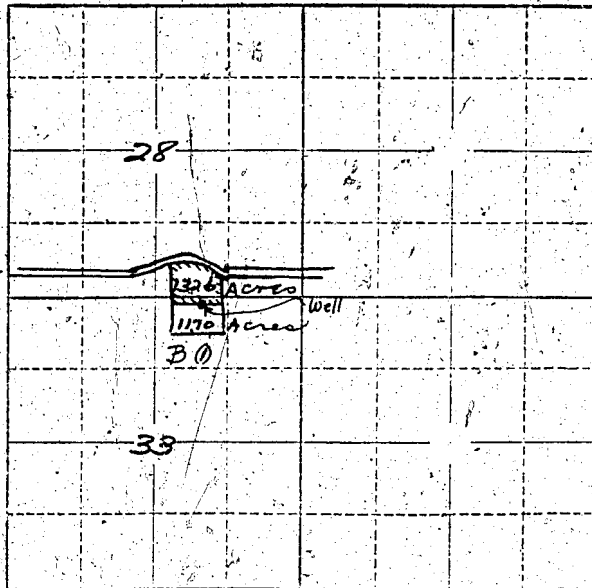

Locate well and acreage of irrigated land on plat.
Scale: 2" = 1 Mile

STATE OF OREGON

County of Marion } ss.

I, _____, being first duly sworn, do hereby certify that I have read the foregoing Registration Statement and that all of the items therein contained are true to the best of my knowledge and belief.

(Signature of Registrant)

Subscribed and sworn to before me this 19 day of _____, 19__

MY COMMISSION EXPIRES JAN. 28, 1969

My commission expires _____

(Notary Public)

(SEAL)

CERTIFICATE OF REGISTRATION

STATE OF OREGON

County of Marion } ss.

This is to certify that the foregoing Registration Statement was received in the office of the State Engineer on the 17 day of Feb., 1958, at 11:00 o'clock A.M. and has been duly recorded in said office in Book No. 5 of Registration Statements on page 1001.

Construction shall be completed by _____ and the water completely applied to beneficial use by _____

Witness my hand this 28 day of May 1958

(State Engineer)

By _____ (Deputy)

GR-1004 C