

Registration Statement

OF CLAIMANT OF RIGHT TO APPROPRIATE GROUND WATER

TO THE STATE ENGINEER OF OREGON:

I, E. W. Brubaker
of Brooks, Oregon Dist. Box 652 County of Marion
(Mailing address)
State of Oregon, do hereby make application for a certificate of registration as evidence of a right to appropriate ground water.

1. Source from which water is withdrawn is Pump well #1
(Flowing well, pump well, infiltration trench, or tunnel)
2. Location is: 1/4 mile East from Brooks Oregon
(Approximate distance and direction from nearest city or town)

and is more particularly described as follows:

(a) 200 feet north & 200 feet west from S.E. corner section 17
(Give distance and bearing to corner of section of other legal subdivision)
being within SE 1/4 of SE 1/4 of Sec. 17, Twp. 6S, Rge. 2W
(Smallest legal subdivision) (N. or S.) (E. or W.)
or (b) within limits of recorded platted property, town or city:
in Lot _____, Block _____ of _____
(Name of plat or addition)

County of _____
(If within city or town, give name)

3. Construction Work was begun on May 1938; was completed on May 1938
(Date) (Date)
and the ground water claimed was first used for the purposes set out below on May 1951
(Date)
since which time the water has been used Intermittently during season
(Continuously or intermittently)
from May 51 to Oct 51
(Date) (Date)

4. Quantity of water claimed and used is 60 gallons per minute; _____ acre feet per year.

5. Purpose or Purposes for which water is used Irrigation
(Domestic, irrigation, municipal, manufacturing, industrial, etc.)

6. Description of Well: Depth 85 feet. Type Drilled
(Dug or drilled)
diameter 6 inches. Elevation of ground at well site 176 feet, mean sea level.
(As near as known)
Depth to water table 16 feet.

7. Capacity of Well: 50 g.p.m. with 28 feet drawdown.
_____ g.p.m. with _____ feet drawdown.

Date of test May 1938


If Flowing Well: Measured discharge _____ g.p.m. on _____
(Date)

Shut-in pressure at ground surface _____ lbs. per sq. in. on _____
(Date)

Water is controlled by _____
(Cap, valve, etc.)

180

Township 76S Range R2W, W.M.
North

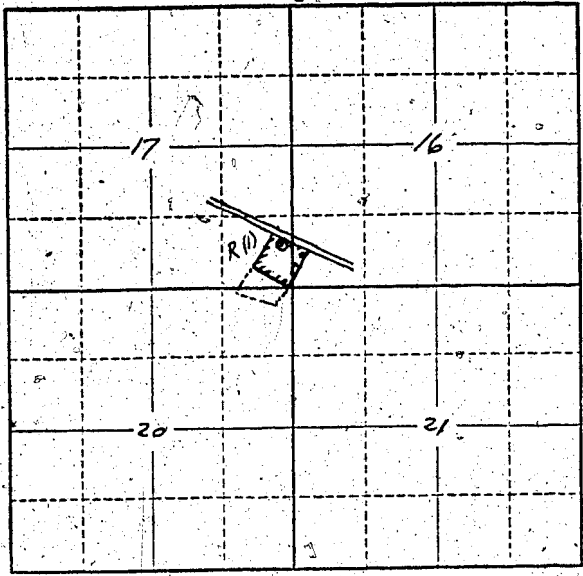

Locate well and acreage of irrigated land on plat.
Scale: 2" = 1 Mile

STATE OF OREGON }
County of Marion Co. } ss.

I, _____, being first duly sworn, do hereby certify that I have read the foregoing Registration Statement and that all of the items therein contained are true to the best of my knowledge and belief.

E. W. Broutha
(Signature of Registrant)

Subscribed and sworn to before me this 19th day of February, 1958

My commission expires 12th June 1961 Wm. S. Bartholomew
(Notary Public)

(SEAL)

CERTIFICATE OF REGISTRATION

STATE OF OREGON }
County of Marion } ss.

This is to certify that the foregoing Registration Statement was received in the office of the State Engineer on the 19th day of January, 1958, at 11:30 o'clock P. M. and has been duly recorded in said office in Book No. 5 of Registration Statements on page GR-1007C

Witness my hand this 30th day of June, 1958.
Lewis J. Silvers
(State Engineer)

By _____
(Deputy)