

RECEIVED
FEB 24 1952

Registration No. GR - 1046
Certificate No. GR - 1008

Registration Statement

OF CLAIMANT OF RIGHT TO APPROPRIATE GROUND WATER

TO THE STATE ENGINEER OF OREGON:

I, Vivian Frerksen

of Route 3, Albany County of Linn
(Mailing address)

State of Oregon, do hereby make application for a certificate of registration as evidence of a right to appropriate ground water.

1. Source from which water is withdrawn is Pump well
(Flowing well, pump well, infiltration trench, or tunnel)

2. Location is: 3 1/2 miles west of Albany, Oregon
(Approximate distance and direction from nearest city or town)

and is more particularly described as follows:

(a) N. 73° 15' E. 20.75 chains from SW corner of SE 1/4 of S. 15, T. 11 S., R. 2 W.
(Give distance and bearing to corner of section or other legal subdivision)

being within _____ of Sec. _____ Twp. _____ Rge. _____
(Smallest legal subdivision) (N. or S.) (E. or W.)

or (b) within limits of recorded platted property, town or city:

in Lot _____, Block _____ of _____
(Name of plat or addition)

County of Linn
(If within city or town, give name)

3. Construction Work was begun on July 1952; was completed on July 1952
(Date) (Date)

and the ground water claimed was first used for the purposes set out below on July 1952
(Date)

since which time the water has been used continuously
(Continuously or intermittently)

from July 1952 to present time
(Date) (Date)

4. Quantity of water claimed and used is 50 gallons per minute; 56.5 acre feet per year.

5. Purpose or Purposes for which water is used Irrigation

(Domestic, irrigation, municipal, manufacturing, industrial, etc.)

6. Description of Well: Depth 48 feet. Type Drilled
(Dug or drilled)

diameter 8 inches. Elevation of ground at well site 215 feet, mean sea level.
(As near as known)

Depth to water table 12 feet.

7. Capacity of Well: Not known g.p.m. with _____ feet drawdown.

_____ g.p.m. with _____ feet drawdown.

Date of test _____

If Flowing Well: Measured discharge _____ g.p.m. on _____
(Date)

Shut-in pressure at ground surface _____ lbs. per sq. in. on _____
(Date)

Water is controlled by _____
(Cap, valve, etc.)

8. Casing: (Give diameter, commercial specifications and depth below ground surface of each casing size.)

8 inch diameter steel casing from 0 to 48 feet
inch diameter from to feet
inch diameter from to feet
inch diameter from to feet

Describe and show depth of shoe, plug, adapter, liner or other details:

9. Perforated Casings or Screens:

slot perforations from 40 to 48 feet
(Number per foot and size of perforations, or describe screen)
from to
from to
from to

10. Log of Well: (Describe each stratum or formation clearly, indicate if water bearing, and give thickness and depth as indicated.)

MATERIAL	Thickness (Feet)	Depth to Bottom (Feet)
Not available		

If log of well is not available, give name and address of driller. Wm. Shaffer, Philomath, Oregon

11. Infiltration Trench: Covered or open

Dimensions: Length ft. Minimum depth ft. Maximum depth ft.

Bottom width ft. Discharge g.p.m. Date of test

12. Tunnel: Type of lining

Dimensions:
(Length, course, and cross sectional size)

Position of water bearing stratum with reference to portal of tunnel

Log of tunnel: (Preceding table for log of well may be used, if desired. Give footage from portal and character of materials, as pertinent.)

13. Pumping Equipment:

(a) Pump Fairbanks Morse Deep Well turbine Capacity 100 g.p.m.
(Make, type and size)

(b) Motor 5 H. P. electric
(Type and horsepower)


14. Location of area irrigated or to be irrigated, or place of use if for purposes other than irrigation.

Township North or South	Range E. or W. of Willamette Meridian	Section	Forty-acre Tract	Number Acres To Be Irrigated	Date of Reclamation
11 S	4 W	15	SW $\frac{1}{4}$ of SE $\frac{1}{4}$	6.0	July 1952
11 S	4 W	15	SE $\frac{1}{4}$ of SE $\frac{1}{4}$	9.4	" "
11 S	4 W	22	NE $\frac{1}{4}$ of NE $\frac{1}{4}$	3.0	" "
11 S	4 W	22	NW $\frac{1}{4}$ of NE $\frac{1}{4}$	4.2	" "
				22.6	

Beginning at a point which is West 20.00 chains distant and North 15.58 chains distant from the Southeast corner of the East Ell of the Donation Land Claim of William Moore, same being Not. No. 1790 and Claim No. 60 in Township 11, South, Range 4 West of the Willamette Meridian in Linn County, Oregon, running thence North 21.07 chains to the North boundary line of said Claim, thence West along said boundary line 35.41 chains to the center of the county road, thence South 10' 40" West along the center of said road 21.59 chains, thence East 36.06 chains to the place of beginning, containing 76.22 acres, more or less in Linn County, Oregon.

15. If the ground water supply is supplemental to an existing water supply, identification of any application for a permit, permit, certificate or adjudicated right to appropriate water made or held by the registrant.

Township 11 S Range 4W, W.M.
North

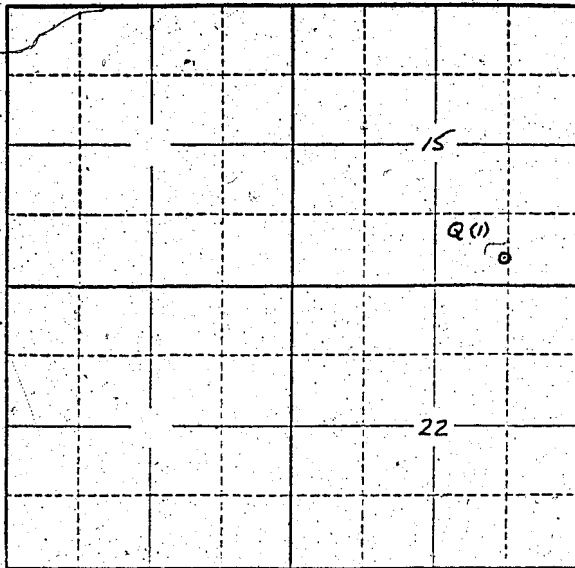

Locate well and acreage of irrigated land on plat.
Scale: 2" = 1 Mile

STATE OF OREGON

County of Linn

ss.

I, Vivian Frerksen, being first duly sworn, do hereby certify that I have read the foregoing Registration Statement and that all of the items therein contained are true to the best of my knowledge and belief.

(Signature of Registrant)

Subscribed and sworn to before me this 15 day of February, 1958.

My commission expires February 15, 1959

(Notary Public)

(SEAL)

CERTIFICATE OF REGISTRATION

STATE OF OREGON

County of Marion

ss.

This is to certify that the foregoing Registration Statement was received in the office of the State Engineer on the 20th day of February, 1958, at 8:00 o'clock A.M. and has been duly recorded in said office in Book No. 5 of Registration Statements on page GR-1008C

Witness my hand this 30th day of June, 1958

Lewis A. Stanley
(State Engineer)

By

(Deputy)

GR-1008C