

Registration No. GR - 1049

Certificate No. GR - 1011

Registration Statement

OF CLAIMANT OF RIGHT TO APPROPRIATE GROUND WATER

TO THE STATE ENGINEER OF OREGON:

I, Alex Stein

of 1180 Claret St
(Mailing address)

County of Marion

State of Oregon, do hereby make application for a certificate of registration as evidence of a right to appropriate ground water.

1. Source from which water is withdrawn is Pump Well
(Flowing well, pump well, infiltration trench, or tunnel)

2. Location is: S 1/4 5 Miles North
(Approximate distance and direction from nearest city or town)

and is more particularly described as follows:

(a) 500' S & 500' E from NW Corner Section 3
(Give distance and bearing to corner of section or other legal subdivision)

being within NW 1/4 NW 1/4 of Sec. 3, Twp. 7 S, Rge. 3 W
(Smallest legal subdivision) (N. or S.) (E. or W.)

or (b) within limits of recorded platted property, town or city:

in Lot _____, Block _____ of _____
(Name of plat or addition)

County of _____
(If within city or town, give name)

3. Construction Work was begun on May 7, 1955; was completed on _____
(Date) (Date)

and the ground water claimed was first used for the purposes set out below on May 11, 1955
(Date)

since which time the water has been used 1 Month Yearly
(Continuously or Intermittently)

from July to August
(Date) (Date)

4. Quantity of water claimed and used is 150 gallons per minute; _____ acre feet per year.

5. Purpose or Purposes for which water is used Domestic
(Domestic, irrigation, municipal, manufacturing, industrial, etc.)

6. Description of Well: Depth 55 feet. Type Dug
(Dug or drilled)
diameter _____ inches. Elevation of ground at well site 130 feet, mean sea level.
(As near as known)
Depth to water table 10 feet.

7. Capacity of Well: 150 g.p.m. with 10 feet drawdown.
_____ g.p.m. with _____ feet drawdown.


Date of test May 17, 1955

If Flowing Well: Measured discharge _____ g.p.m. on _____
(Date)

Shut-in pressure at ground surface _____ lbs. per sq. in. on _____
(Date)

Water is controlled by _____
(Cap, valve, etc.)

Township 6475 Range 3 W, W.M.

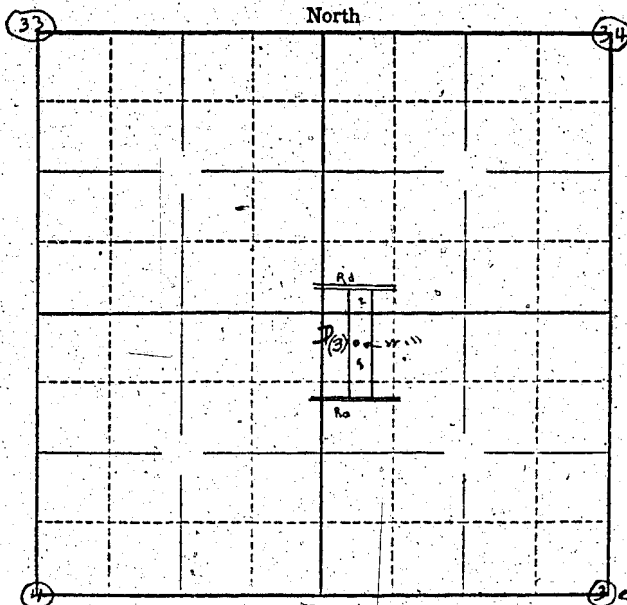

Locate well and acreage of irrigated land on plat.

Scale: 1" = 1 Mile

STATE OF OREGON

County of Marion

ss.

I, _____, being first duly sworn, do hereby certify that I have read the foregoing Registration Statement and that all of the items therein contained are true to the best of my knowledge and belief.

Alex Stain
(Signature of Registrant)

Subscribed and sworn to before me this 21st day of February, 1958

My commission expires 12th June 1961 Wm. S. Bartholomew
(Notary Public)

(SEAL)

CERTIFICATE OF REGISTRATION

STATE OF OREGON

County of Marion

ss.

This is to certify that the foregoing Registration Statement was received in the office of the State Engineer on the 21st day of February, 1958, at 9:30 o'clock 7 A.M. and has been duly recorded in said office in Book No. 5 of Registration Statements on page GR-1011C

Witness my hand this 30th day of June, 1958.

Laura A. Stanley
(State Engineer)

By _____
(Deputy)

GR-1011C