

Registration Statement

OF CLAIMANT OF RIGHT TO APPROPRIATE GROUND WATER

(Under Chapter 708, Oregon Laws 1955.)

TO THE STATE ENGINEER OF OREGON:

I, Louis Schmerberof Gervais, County of MarionState of Oregon, do hereby make application for a certificate of registration as evidence of a right to appropriate ground water.1. Source from which water is withdrawn is Pump Well
(Flowing well, pump well, infiltration trench, or tunnel)2. Location is: 6 miles West of Gervais
(Approximate distance and direction from nearest city or town)

and is more particularly described as follows:

(a) Beginning at North West corner of Sec. 31 thence 5
South 4 chains; thence South 89° 50' East 30 chains to pump.
(Give distance and bearings to corner of section or other legal subdivision)being within N.W. 1/4 of N.W. 1/4 of Sec. 31, Twp. S.S., Rge. 2 W
(Smallest legal subdivision) (N. or S.) (E. or W.)

or (b) within limits of recorded platted property, town or city:

in Lot _____ Block _____ of _____
(Name of plat or addition)

(If within city or town, give name)

3. Construction Work was begun on 7-10-52; was completed on 8-2-52
(Date) (Date)and the ground water claimed was first used for the purposes set out below on 8-10-52
(Date)since which time the water has been used intermittently
(Continuously or intermittently)from 5-1-53 to 10-1-55
(Date) (Date)4. Quantity of water claimed and used is 450 gallons per minute; 150 acre
feet per year.5. Purpose or Purposes for which water is used irrigation

(Domestic, irrigation, municipal, manufacturing, industrial, etc.)

6. Description of Well: Depth 94 feet. Type Drilled
(Dug or drilled)diameter 12 inches. Elevation of ground at well site 740 feet, mean sea level.
(As near as known)Depth to water table 18 feet.7. Capacity of Well: 450 g.p.m. with 65 feet drawdown.200 g.p.m. with 35 feet drawdown.Date of test 8-2-52If Flowing Well: Measured discharge _____ g.p.m. on _____
(Date)Shut-in pressure at ground surface _____ lbs. per sq. in. on _____
(Date)Water is controlled by _____
(Cap, valve, etc.)

8. Casing: (Give diameter, commercial specifications and depth below ground surface of each casing size.)

12 inch diameter *Steel pipe* from *6" above Gr.* to *94* feet
 inch diameter from to feet
 inch diameter from to feet
 inch diameter from to feet

Describe and show depth of shoe, plug, adapter, liner or other details:

9. Perforated Casings or Screens:

1/4" - 1/8" perforations 8" long per ft. spaced 4" from *74* to *94*
(Number per foot and size of perforations, or describe screen)
Round circumference of pipe from to
 from to
 from to

10. Log of Well: (Describe each stratum or formation clearly, indicate if water bearing, and give thickness and depth as indicated.)

MATERIAL	Thickness (Feet)	Depth to Bottom (Feet)
<i>Clay and loam</i>	<i>10</i>	
<i>silt</i>	<i>32</i>	
<i>Fine sand (grey)</i>	<i>48</i>	
<i>Blue clay</i>	<i>1 1/2</i>	
<i>Coarse gravel & Sand</i>	<i>2 1/2</i>	<i>94</i>

Note: - No log was kept by driller. The above data was made or kept by owner at various times from information obtained from driller and by personal observation as drilling was done.

If log of well is not available, give name and address of driller. Northwest Drilling Co.
Not in operation (defunct) at this date.

11. Infiltration Trench: Covered or open
Dimensions: Length ft. Minimum depth ft. Maximum depth ft.
Bottom width ft. Discharge g.p.m. Date of test

12. Tunnel: Type of lining
Dimensions:
(Length, course, and cross sectional size)
Position of water bearing stratum with reference to portal of tunnel

Log of tunnel: (Preceding table for log of well may be used, if desired. Give footage from portal and character of materials, as pertinent.)


13. Pumping Equipment:
(a) Pump Jaccuzzi, Turbine 5" Capacity 450 g.p.m.
(Make, type and size)
(b) Motor Three Phase 1750 R.P.M. 20 H.P. U.S.
(Type and horsepower)

14. Location of area irrigated or to be irrigated, or place of use if for purposes other than irrigation.

Township North or South	Range E. or W. of Willamette Meridian	Section	Forty-acre Tract	Number Acres To Be Irrigated	Date of Reclamation
<u>5 South</u>	<u>R. 2 W</u>	<u>30</u>	<u>SW 1/4 of SW 1/4</u>	<u>18</u>	<u>8-10-52</u>
		<u>30</u>	<u>SE 1/4 of SW 1/4</u>	<u>15</u>	<u>8-10-52</u>
		<u>31</u>	<u>NW 1/4 of NW 1/4</u>	<u>24</u>	<u>8-10-52</u>
		<u>31</u>	<u>NE 1/4 of NW 1/4</u>	<u>18</u>	<u>8-10-52</u>
				<u>75</u>	

15. If the ground water supply is supplemental to an existing water supply, identification of any application for a permit, permit, certificate or adjudicated right to appropriate water made or held by the registrant.

Township 5 S. Range 2 W. W.M.
North

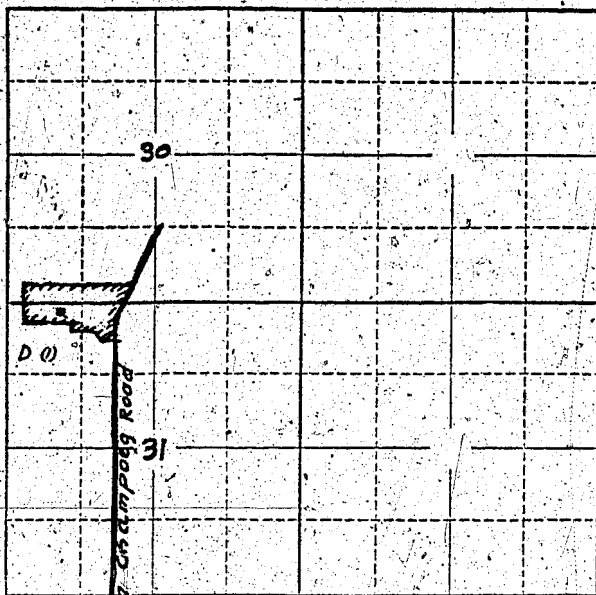

Locate well and acreage of irrigated land on plat.
Scale: 2" = 1 Mile

STATE OF OREGON

County of Marion } ss.

I, Louis Schmerber, being first duly sworn, do hereby certify that I have read the foregoing Registration Statement and that all of the items therein contained are true to the best of my knowledge and belief.

Louis Schmerber
(Signature of Registrant)

Subscribed and sworn to before me this 9th day of February, 1956.

My commission expires September 8, 1956
Max S. Lewis
(Notary Public)

(SEAL)

CERTIFICATE OF REGISTRATION

STATE OF OREGON

County of Marion } ss.

This is to certify that the foregoing Registration Statement was received in the office of the State Engineer on the 9th day of February, 1956, at 8:00 o'clock A.M. and has been duly recorded in said office in Book No. 1 of Registration Statements on page GR-97C.

~~Construction shall be completed by _____ and the water completed applied to beneficial use by _____~~

Witness my hand this 12th day of April, 1956

Lewis A. Stanley
(State Engineer)

By _____
(Deputy)

GR-97 C