

Registration Statement

OF CLAIMANT OF RIGHT TO APPROPRIATE GROUND WATER

TO THE STATE ENGINEER OF OREGON:

I, M. Van Buskirk
of MT Angel County of Marion
(Mailing address)

State of Oregon, do hereby make application for a certificate of registration as evidence of a right to appropriate ground water.

1. Source from which water is withdrawn is Pump well
(Flowing well, pump well, infiltration trench, or tunnel)

2. Location is: 2/3 mi West Mt Angel
(Approximate distance and direction from nearest city or town)

and is more particularly described as follows: 200 feet South & 50 feet east from N 1/4 Section 9

(a) Part 9 Settlement Land Claim
(Give distance and bearing to corner of section or other legal subdivision)

being within NW 1/4 of NE 1/4 of Sec. 9, Twp. 6 S, Rge. 1 W
(Smallest legal subdivision) (N. or S.) (E. or W.)

or (b) within limits of recorded platted property, town or city:

in Lot _____, Block _____ of _____
(Name of plat or addition)

County of _____
(If within city or town, give name)

3. Construction Work was begun on May 52 and was completed on Same
(Date) (Date)

and the ground water claimed was first used for the purposes set out below on June 1953
(Date)

since which time the water has been used intermittently during season
(Continuously or Intermittently)

from May '53 to Oct '57
(Date) (Date)

4. Quantity of water claimed and used is 200 gallons per minute: _____ acre feet per year.

5. Purpose or Purposes for which water is used irrigation

6. Description of Well: Depth 95 feet. Type dug
(Domestic, irrigation, municipal, manufacturing, industrial, etc.) (Dug or drilled)

diameter 8 inches. Elevation of ground at well site 148 feet, mean sea level.
(As near as known)

Depth to water table 20 feet.

7. Capacity of Well: 175 g.p.m. with 70 feet drawdown.

200 g.p.m. with 85 feet drawdown.


Date of test 1954

If Flowing Well: Measured discharge 5 g.p.m. on During Winter months
(Date)

Shut-in pressure at ground surface _____ lbs. per sq. in. on _____
(Date)

Water is controlled by None
(Cap, valve, etc.)

Township 65 Range 14 W.M.
North

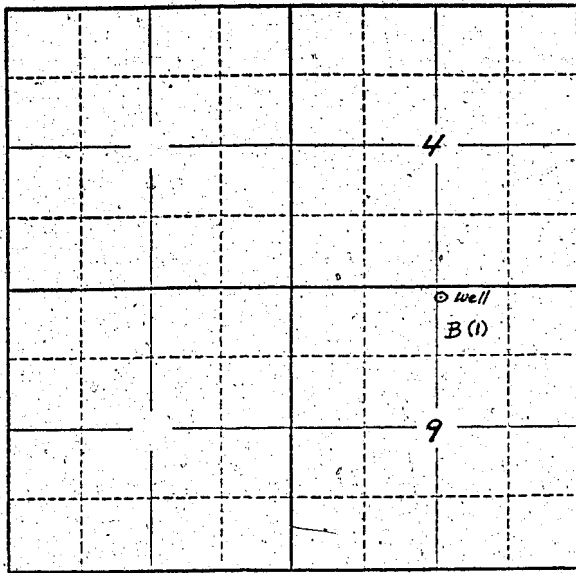

Locate well and acreage of irrigated land on plat.

Scale: 2" = 1 Mile

STATE OF OREGON

County of Marion

I, Wm. S. Bartholomew, being first duly sworn, do hereby certify that I have read the foregoing Registration Statement and that all of the items therein contained are true to the best of my knowledge and belief.

Wm. S. Bartholomew
(Signature of Registrant)

Subscribed and sworn to before me this 21st day of February, 1958

My commission expires 12th June 1961

Wm. S. Bartholomew
(Notary Public)

(SEAL)

CERTIFICATE OF REGISTRATION

STATE OF OREGON

County of Marion

This is to certify that the foregoing Registration Statement was received in the office of the State Engineer on the 21st day of February, 1958, at 12:00 o'clock A.M. and has been duly recorded in said office in Book No. 5 of Registration Statements on page GR-1012 C

Witness my hand this 30th day of June, 1958

Linda A. Stanley
(State Engineer)

By [Signature]
(Deputy)

GR-1012 C