

Registration Statement

OF CLAIMANT OF RIGHT TO APPROPRIATE GROUND WATER

TO THE STATE ENGINEER OF OREGON:

I, Harry Reuzelman
 of P.O. Box 159, Independence County of Polk
(Mailing address)
 State of Oregon, do hereby make application for a certificate of registration as evidence
 of a right to appropriate ground water.

1. Source from which water is withdrawn is pump well
(Flowing well, pump well, infiltration trench, or tunnel)
2. Location is: 1 1/2 miles south of Independence
(Approximate distance and direction from nearest city or town)

and is more particularly described as follows:

(a) 3080 ft. west + 1550 north of SE corner section 33
(Give distance and bearing to corner of section or other legal subdivision)
 being within NE 1/4 of SW 1/4 of Sec. 33, Twp. 8S, Rge. 4W
(Smallest legal subdivision) (N. or S.) (E. or W.)
 or (b) within limits of recorded platted property, town or city:
 in Lot _____, Block _____ of _____
(Name of plat or addition)

County of _____
(If within city or town, give name)

3. Construction Work was begun on Oct 1947; was completed on Nov 1947
(Date) (Date)
 and the ground water claimed was first used for the purposes set out below on May 1, 1949
(Date)
 since which time the water has been used intermittently
(Continuously or intermittently)
 from May 1, 1949 to Sept 15, '57
(Date) (Date)

4. Quantity of water claimed and used is 100 gallons per minute; 30 acre feet per year.

5. Purpose or Purposes for which water is used irrigation
(Domestic, irrigation, municipal, manufacturing, industrial, etc.)

6. Description of Well: Depth 50 feet. Type drilled
(Dug or drilled)
 diameter 10 inches. Elevation of ground at well site 172 feet, mean sea level.
(As near as known)
 Depth to water table 20 feet.

7. Capacity of Well: _____ g.p.m. with _____ feet drawdown.
 _____ g.p.m. with _____ feet drawdown.

Date of test _____

If Flowing Well: Measured discharge _____ g.p.m. on _____
(Date)

Shut-in pressure at ground surface _____ lbs. per sq. in. on _____
(Date)

Water is controlled by _____
(Cap, valve, etc.)

If log of well is not available, give name and address of driller. Arp Clinton
Main Street Independence

11. Infiltration Trench: Covered or open
 Dimensions: Length ft. Minimum depth ft. Maximum depth ft.
 Bottom width ft. Discharge g.p.m. Date of test

12. Tunnel: Type of lining
 Dimensions:
(Length, course, and cross sectional size)
 Position of water bearing stratum with reference to portal of tunnel

Log of tunnel: (Preceding table for log of well may be used, if desired. Give footage from portal and character of materials, as pertinent.)


13. Pumping Equipment: 12 stage 6 TR-40, 1750 R.P.M.
 (a) Pump Cook Centrifugal Capacity 150 g.p.m. 150 FT head
(Make, type and size)
 (b) Motor Electric 3 phase 5 horse power
(Type and horsepower)

14. Location of area irrigated or to be irrigated, or place of use if for purposes other than irrigation.

Township North or South	Range E. or W. of Willamette Meridian	Section	Forty-acre Tract	Number Acres To Be Irrigated	Date of Reclamation
<u>T8S</u>	<u>R4W</u>	<u>33</u>	<u>NE 1/4 of SW 1/4</u>	<u>11.5</u>	<u>1949</u>
<u>"</u>	<u>"</u>	<u>33</u>	<u>NW 1/4 of SE 1/4</u>	<u>05</u>	<u>"</u>
				<u>120</u>	<u>.</u>

15. If the ground water supply is supplemental to an existing water supply, identification of any application for a permit, permit, certificate or adjudicated right to appropriate water made or held by the registrant.

Township 8S Range 4W, W.M.
North

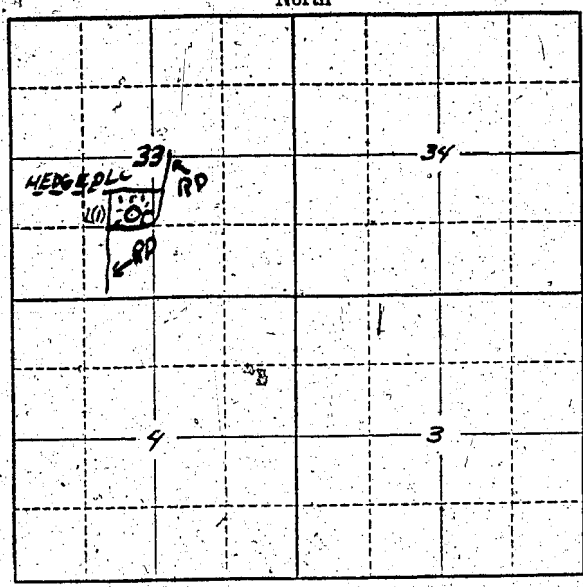

Locate well and acreage of irrigated land on plat.
Scale: 2" = 1 Mile

STATE OF OREGON }
County of Marion } ss.

I, _____, being first duly sworn, do hereby certify that I have read the foregoing Registration Statement and that all of the items therein contained are true to the best of my knowledge and belief.

Harry Rengelmann
(Signature of Registrant)

Subscribed and sworn to before me this 21st day of February, 1958

My commission expires 12th June 1961

Wm. S. Bartholomew
(Notary Public)

(SEAL)

CERTIFICATE OF REGISTRATION

STATE OF OREGON }
County of Marion } ss.

This is to certify that the foregoing Registration Statement was received in the office of the State Engineer on the 21st day of February, 1958 at 1:30 o'clock P. M. and has been duly recorded in said office in Book No. 5 of Registration Statements on page GR-1013C

Witness my hand this 30th day of June, 1958

Edwin A. Miller
(State Engineer)

By _____ (Deputy)