

Registration Statement

OF CLAIMANT OF RIGHT TO APPROPRIATE GROUND WATER

TO THE STATE ENGINEER OF OREGON:

I, GEORGE STAPLETON
of INDEPENDENCE County of Polk
(Mailing address)

State of Oregon do hereby make application for a certificate of registration as evidence of a right to appropriate ground water.

- 1. Source from which water is withdrawn is Pump well #1
(Flowing well, pump well, infiltration trench, or tunnel)
- 2. Location is: 2 1/2 S. of Independence, Oreg.
(Approximate distance and direction from nearest city or town)

and is more particularly described as follows:

(a) 2000 feet south & 1420 feet east from NW corner Section 4
(Give distance and bearing to corner of section or other legal subdivision)
being within SE 1/4 of NW 1/4 of Sec. 4, Twp. 9 S, Rge. 4 W
(Smallest legal subdivision) (or S) (or W)

(b) within limits of recorded platted property, town or city:

in Lot _____, Block _____ of _____
(Name of plat or addition)
County of _____
(If within city or town, give name)

3. Construction Work was begun on Oct. 1944; was completed on Oct. 1944
(Date) (Date)

and the ground water claimed was first used for the purposes set out below on April 1945
(Date)
since which time the water has been used intermittently during season
(Continually or intermittently)
from April 45 to Oct. 1957
(Date) (Date)

4. Quantity of water claimed and used is 200 gallons per minute; _____ acre feet per year.

5. Purpose or Purposes for which water is used Irrigation
(Domestic, irrigation, municipal, manufacturing, industrial, etc.)

6. Description of Well: Depth 42 feet; Type Drilled
(Dug or drilled)
diameter 12 inches. Elevation of ground at well site 180 feet, mean sea level.
(As near as known)
Depth to water table 24 feet. Summer measure

7. Capacity of Well: 200 g.p.m. with 2 feet drawdown.
_____ g.p.m. with _____ feet drawdown.


Date of test Oct. 1944

If Flowing Well: Measured discharge _____ g.p.m. on _____
(Date)

Shut-in pressure at ground surface _____ lbs. per sq. in. on _____
(Date)

Water is controlled by _____
(Cap, valve, etc.)

Township 9S Range 4W W.M.
North

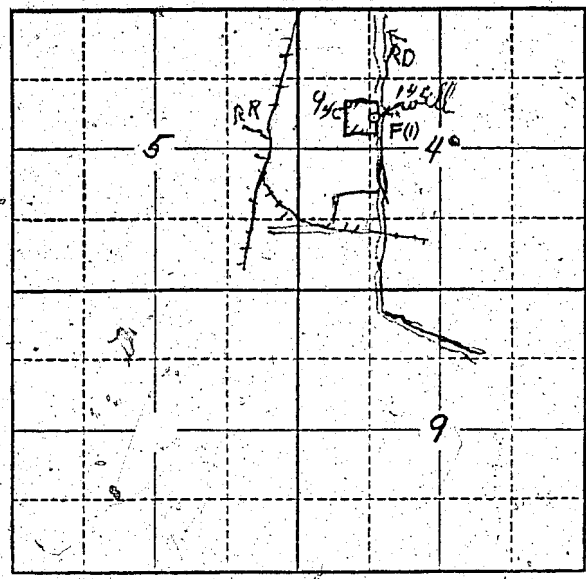

Locate well and acreage of irrigated land on plat.
Scale: 2" = 1 Mile

STATE OF OREGON }
County of Marion } ss.

I, _____, being first duly sworn, do hereby certify that I have read the foregoing Registration Statement and that all of the items therein contained are true to the best of my knowledge and belief.

George Stapleton
(Signature of Registrant)

Subscribed and sworn to before me this 21st day of February, 1958

My commission expires 12th June 1961 Wm. S. Bartholmeis
(Notary Public)

(SEAL)

CERTIFICATE OF REGISTRATION

STATE OF OREGON }
County of Marion } ss.

This is to certify that the foregoing Registration Statement was received in the office of the State Engineer on the 21st day of February, 1958, at 9:00 o'clock A. M. and has been duly recorded in said office in Book No. 5 of Registration Statements on page GR-1014C

Witness my hand this 30th day of June, 1958

Lewis A. Stanley
(State Engineer)

By _____ (Deputy)