

Registration No. GR - 1055

Certificate No. GR - 1017

Registration Statement

OF CLAIMANT OF RIGHT TO APPROPRIATE GROUND WATER

TO THE STATE ENGINEER OF OREGON:

I, Leroy McGill and Derooy McGill, D.B.A. McGill Bros.

of Marion County of Marion

(Mailing address)

State of Oregon, do hereby make application for a certificate of registration as evidence of a right to appropriate ground water.

1. Source from which water is withdrawn is Pump Well #2

(Flowing well, pump well, infiltration trench, or tunnel)

2. Location is: 1 1/2 miles south of Marion

(Approximate distance and direction from nearest city or town)

and is more particularly described as follows:

(a) Well No. (2) 1800' S. and 1201' East of N.W. cor. of Wm. McKinney D.L.C.

(Give distance and bearing to corner of section or other legal subdivision)

being within N.E. 1/4 of S.E. 1/4 of Sec. 5, Twp. 10 S, Rge. 2 W

(Smallest legal subdivision)

(N. or S.)

(E. or W.)

or (b) within limits of recorded platted property, town or city:

in Lot _____, Block _____ of _____

(Name of plat or addition)

(If within city or town, give name)

County of _____

3. Construction Work was begun on December 5, 1946 was completed on Feb. 6, 1947

(Date)

(Date)

and the ground water claimed was first used for the purposes set out below on May 1, 1947

(Date)

since which time the water has been used intermittently

(Continuously or intermittently)

from May 1 to Oct. 1957

(Date)

(Date)

4. Quantity of water claimed and used is 350 gallons per minute; 230 acre feet per year.

5. Purpose or Purposes for which water is used Irrigation

(Domestic, irrigation, municipal, manufacturing, industrial, etc.)

6. Description of Well: Depth 40 feet. Type Drilled

(Dug or drilled)

diameter 8 inches. Elevation of ground at well site 277 feet, mean sea level.

(As near as known)

Depth to water table 10 feet.

7. Capacity of Well: 400 g.p.m. with 18 feet drawdown.

g.p.m. with _____ feet drawdown.

Date of test Feb. 1947

If Flowing Well: Measured discharge _____ g.p.m. on _____

(Date)

Shut-in pressure at ground surface _____ lbs. per sq. in. on _____

(Date)

Water is controlled by _____

(Cap, valve, etc.)

8. Casing: (Give diameter, commercial specifications and depth below ground surface of each casing size.)

8 inch diameter Steel casing from 0 to 40 feet
 inch diameter from to feet
 inch diameter from to feet
 inch diameter from to feet

Describe and show depth of shoe, plug, adapter, liner or other details:

9. Perforated Casings or Screens:

3 per ft. $\frac{1}{2} \times 6"$ from 25 ft. to 40 ft.

(Number per foot and size of perforations, or describe screen)

from to
 from to
 from to

10. Log of Well: (Describe each stratum or formation clearly, indicate if water bearing, and give thickness and depth as indicated.)

MATERIAL	Thickness (Feet)	Depth to Bottom (Feet)

If log of well is not available, give name and address of driller. West Well Drilling
4120 Market St. Salem, Oregon

11. Infiltration Trench: Covered or open

Dimensions: Length ft. Minimum depth ft. Maximum depth ft.
 Bottom width ft. Discharge g.p.m. Date of test

12. Tunnel: Type of lining

Dimensions:
(Length, course, and cross sectional size)
 Position of water bearing stratum with reference to portal of tunnel

Log of tunnel: (Preceding table for log of well may be used, if desired. Give footage from portal and character of materials, as pertinent.)

13. Pumping Equipment:


(a) Pump Pacific Centrifugal 3" Capacity 350 g.p.m.
(Make, type and size)
 (b) Motor 15 H.P. 3 Phase Electric
(Type and horsepower)

14. Location of area irrigated or to be irrigated, or place of use if for purposes other than irrigation.

Township North or South	Range E. or W. of Willamette Meridian	Section	Forty-acre Tract	Number Acres To Be Irrigated	Date of Reclamation
10 S	2 W	5	S.E. $\frac{1}{4}$ of S.E. $\frac{1}{4}$	15.00 15.00	1951
10 S	2 W	5	N.E. $\frac{1}{4}$ of S.E. $\frac{1}{4}$	32.00 32.00	1945
10 S	2 W	5	S.E. $\frac{1}{4}$ of N.E. $\frac{1}{4}$	5.20 5.20	1941

15. If the ground water supply is supplemental to an existing water supply, identification of any application for a permit, permit, certificate or adjudicated right to appropriate water made or held by the registrant.

Township 10.S Range 24W W.M.
North

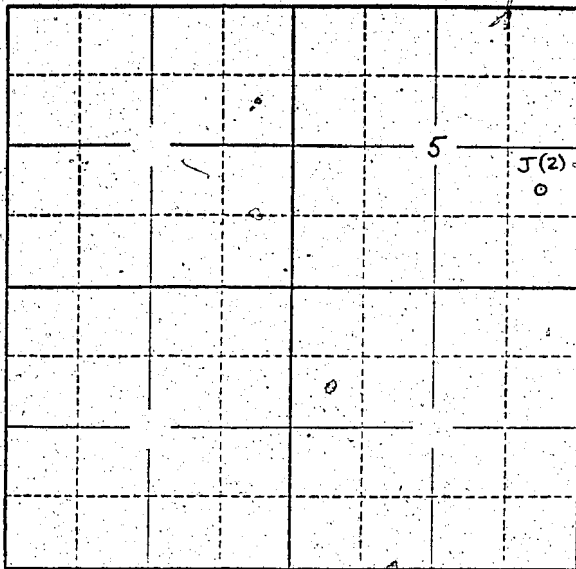

for Map see file
32140

Locate well and acreage of irrigated land on plat.

Scale: 2" = 1 Mile

STATE OF OREGON

County of

Marion

ss.

I, _____, being first duly sworn, do hereby certify that I have read the foregoing Registration Statement and that all of the items therein contained are true to the best of my knowledge and belief.

McMill Bros

(Signature of Registrant)

Subscribed and sworn to before me this 21st day of February, 1958

My commission expires 12th June 1961

Wm. S. Bartholomew

(Notary Public)

(SEAL)

CERTIFICATE OF REGISTRATION

STATE OF OREGON

County of Marion

ss.

This is to certify that the foregoing Registration Statement was received in the office of the State Engineer on the 21st day of February, 1958, at 9:00 o'clock A.M. and has been duly recorded in said office in Book No. 5 of Registration Statements on page GR-1017 C

Witness my hand this 30th day of June, 1958.

Lewis A. Stanley

(State Engineer)

By

(Deputy)

GR - 1017 C