

Registration Statement

OF CLAIMANT OF RIGHT TO APPROPRIATE GROUND WATER

TO THE STATE ENGINEER OF OREGON:

I, R. Stadel
 of Silverton Rte 3, Box 177A County of Mason
(Mailing address)
 State of Oregon, do hereby make application for a certificate of registration as evidence of a right to appropriate ground water.

1. Source from which water is withdrawn is Pump well
(Flowing well, pump well, infiltration trench, or tunnel)
2. Location is: Gregg Co. Dist. 2 miles south of Silverton on Hart road
(Approximate distance and direction from nearest city or town)

and is more particularly described as follows:

(a) 1000' W & 40' N from SE corner of NE 1/4 NE 1/4 Section 9
(Give distance and bearing to corner of section or other legal subdivision)
 being within NE 1/4 NE 1/4 of Sec. 9, Twp. 7.5, Rge. 1.1
(Smallest legal subdivision) (N. or S.) (E. or W.)

or (b) within limits of recorded platted property, town or city:
 in Lot _____, Block _____ of _____
(Name of plat or addition)
 County of _____
(If within city or town, give name)

3. Construction Work was begun on May 1947; was completed on June 1947
(Date) (Date)
 and the ground water claimed was first used for the purposes set out below on _____
(Date)

since which time the water has been used Intermittently
(Continuously or intermittently)
 from 1947 to 1956
(Date) (Date)

4. Quantity of water claimed and used is _____ gallons per minute, _____ acre feet per year.

5. Purpose or Purposes for which water is used _____
(Domestic, irrigation, municipal, manufacturing, industrial, etc.)

6. Description of Well: Depth 75 feet. Type Drilled
(Dug or drilled)
 diameter 12 inches. Elevation of ground at well site 270 feet, mean sea level.
(As near as known)
 Depth to water table 12 feet.

7. Capacity of Well: 75 g.p.m. with _____ feet drawdown.
 _____ g.p.m. with _____ feet drawdown.

Date of test Aug 1947

If Flowing Well: Measured discharge _____ g.p.m. on _____
(Date)

Shut-in pressure at ground surface _____ lbs. per sq. in. on _____
(Date)

Water is controlled by _____
(Cap. valve, etc.)

8. Casing: (Give diameter, commercial specifications and depth below ground surface of each casing size.)

12 inch diameter *standard black pipe* from 0 to 52 feet
 inch diameter from to feet
 inch diameter from to feet
 inch diameter from to feet

Describe and show depth of shoe, plug, adapter, liner or other details: *house made shoe
 made from an old coupling*

9. Perforated Casings or Screens:

4 *perforated* $\frac{1}{2} \times 8'$ at 12 ft. from to
 (Number per foot and size of perforations, or describe screen)
 from to
 from to
 from to

10. Log of Well: (Describe each stratum or formation clearly, indicate if water bearing, and give thickness and depth as indicated.)

MATERIAL	Thickness (Feet)	Depth to Bottom (Feet)
<i>Top soil - brown</i>	<i>4</i>	<i>4</i>
<i>Clay - brown - some water</i>	<i>20</i>	<i>24</i>
<i>Clay - blue</i>	<i>10</i>	<i>34</i>
<i>Clay - red</i>	<i>7</i>	<i>41</i>
<i>Shale - grey</i>	<i>30</i>	<i>71</i>
<i>Yellow & red sand</i>		

If log of well is not available, give name and address of driller.

11. Infiltration Trench: Covered or open

Dimensions: Length ft. Minimum depth ft. Maximum depth ft.

Bottom width ft. Discharge g.p.m. Date of test

12. Tunnel: Type of lining

Dimensions: (Length, course, and cross sectional size)

Position of water bearing stratum with reference to portal of tunnel

Log of tunnel: (Preceding table for log of well may be used, if desired. Give footage from portal and character of materials, as pertinent.)

13. Pumping Equipment: 20 stroke

(a) Pump Capacity 600 g.p.m. (Make, type and size)


(b) Motor John Deere Tractor (Type and horsepower)

14. Location of area irrigated or to be irrigated, or place of use if for purposes other than irrigation.

Township North or South	Range E. or W. of Willamette Meridian	Section	Forty-acre Tract	Number Acres To Be Irrigated	Date of Reclamation
7S	1W	9	NE ¹ / ₄ NE ¹ / ₄	145	

15. If the ground water supply is supplemental to an existing water supply, identification of any application for a permit, permit, certificate or adjudicated right to appropriate water made or held by the registrant. 24856

Township 7S Range 1W, W.M.
North

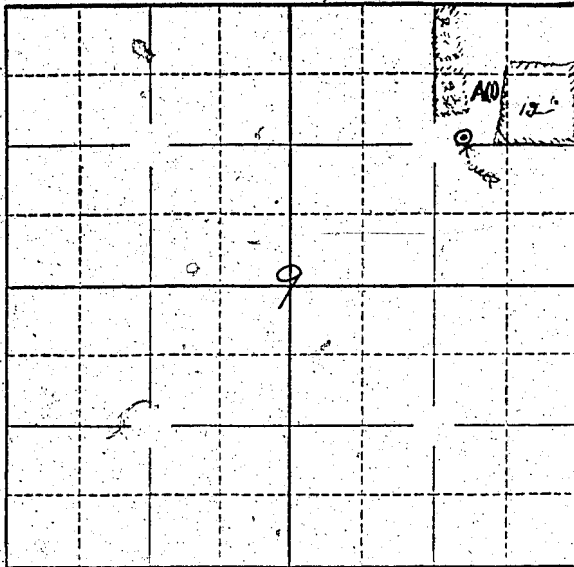

Locate well and acreage of irrigated land on plat.

Scale: ~~2~~ - 1 Mile

STATE OF OREGON

County of Marion

I, R. Stadel, being first ~~day~~ sworn, do hereby certify that I have read the foregoing Registration Statement and that all of the items therein contained are true to the best of my knowledge and belief.

R. Stadel
(Signature of Registrant)

Subscribed and ~~sworn~~ ^{affirmed} to before me this 24 day of February, 1958

My commission expires 9/12/58

[Signature]
(Notary Public)

(SEAL)

CERTIFICATE OF REGISTRATION

STATE OF OREGON

County of Marion

This is to certify that the foregoing Registration Statement was received in the office of the State Engineer on the 24th day of February, 1958, at 10:00 o'clock A.M. and has been duly recorded in said office in Book No. 5 of Registration Statements on page GR-1018C

Witness my hand this 30th day of June, 1958

Laura A. Stanley
(State Engineer)

By _____
(Deputy)