

Registration No. GR - 1057

Certificate No. GR - 1019

# Registration Statement

## OF CLAIMANT OF RIGHT TO APPROPRIATE GROUND WATER

TO THE STATE ENGINEER OF OREGON:

I, James E Davidson  
of RT 1 Box 412 A County of Marion  
(Mailing address)

State of Oregon, do hereby make application for a certificate of registration as evidence of a right to appropriate ground water.

- 1. Source from which water is withdrawn is Pump well  
(Flowing well, pump well, infiltration trench, or tunnel)
- 2. Location is: 2 miles north & west of St. Louis  
(Approximate distance and direction from nearest city or town)

and is more particularly described as follows:  
 (a) 34.35' N 11° 5' E and 75.9' N 71° 49' W of the SW corner of  
Sec. 24, Twp. 5 S, Rge. 2 W  
from NE corner of Section 10  
(Give distance and bearing to corner of section or other legal subdivision)  
 being within N.M. & P.M.S. of Sec. 16, Twp. 5 S, Rge. 2 W  
(Smallest legal subdivision) (N. or S.) (E. or W.)

or (b) within limits of recorded platted property, town or city:  
 in Lot \_\_\_\_\_, Block \_\_\_\_\_ of \_\_\_\_\_  
(Name of plat or addition)  
 County of \_\_\_\_\_  
(If within city or town, give name)

3. Construction Work was begun on Jan. 1952; was completed on April 1952  
(Date) (Date)  
 and the ground water claimed was first used for the purposes set out below on May 1952  
(Date)  
 since which time the water has been used intermittently  
(Continuously or Intermittently)  
 from May 1952 to Sept 1957  
(Date) (Date)

4. Quantity of water claimed and used is 500 gallons per minute; \_\_\_\_\_ acre feet per year.

5. Purpose or Purposes for which water is used irrigation  
(Domestic, irrigation, municipal, manufacturing, industrial, etc.)

6. Description of Well: Depth 114 feet. Type Dug  
(Dug or drilled)  
 diameter 18 inches. Elevation of ground at well site 174 feet, mean sea level.  
(As near as known)  
 Depth to water table 3 feet.

7. Capacity of Well: 750 g.p.m. with 20 feet drawdown.  
 \_\_\_\_\_ g.p.m. with \_\_\_\_\_ feet drawdown.

Date of test March, 1952

If Flowing Well: Measured discharge \_\_\_\_\_ g.p.m. on \_\_\_\_\_  
(Date)

Shut-in pressure at ground surface \_\_\_\_\_ lbs. per sq. in. on \_\_\_\_\_  
(Date)

Water is controlled by \_\_\_\_\_  
(Cap, valve, etc.)

8. Casing: (Give diameter, commercial specifications and depth below ground surface of each casing size.)

14 inch diameter from 0 to 114 feet  
 inch diameter from to feet  
 inch diameter from to feet  
 inch diameter from to feet

Describe and show depth of shoe, plug, adapter, liner or other details:

9. Perforated Casings or Screens:

(Number per foot and size of perforations, or describe screen) from to  
 from to  
 from to  
 from to

10. Log of Well: (Describe each stratum or formation clearly, indicate if water bearing, and give thickness and depth as indicated.)

MATERIAL	Thickness (Feet)	Depth to Bottom (Feet)
Top soil		12
sand - water bearing	17	19
clay	18	74
sand & clay	74	94
clay, hard	94	99
sand, black	99	104
sand clay	104	107
sand	107	113
gravel	113	114

If log of well is not available, give name and address of driller. J.T. Miller

11. Infiltration Trench: Covered or open .....

Dimensions: Length ..... ft. Minimum depth ..... ft. Maximum depth ..... ft.

Bottom width ..... ft. Discharge ..... g.p.m. Date of test .....

12. Tunnel: Type of lining .....

Dimensions: .....  
(Length, course, and cross sectional size)

Position of water bearing stratum with reference to portal of tunnel .....

Log of tunnel: (Preceding table for log of well may be used, if desired. Give footage from portal and character of materials, as pertinent.)

13. Pumping Equipment:

(a) Pump Packard turbine Capacity 500 g.p.m.  
(Make, type and size)


(b) Motor 30 3 phase electric  
(Type and horsepower)

14. Location of area irrigated or to be irrigated, or place of use if for purposes other than irrigation.

Township North or South	Range E. or W. of Willamette Meridian	Section	Forty-acre Tract	Number Acres To Be Irrigated	Date of Reclamation
<u>T5S</u>	<u>R2W</u>	<u>9</u>	<u>SW 1/4 of SW 1/4</u>	<u>7</u>	<u>May 1952</u>
"	"	<u>8</u>	<u>SE 1/4 of SE 1/4</u>	<u>0.5</u>	
"	"	<u>17</u>	<u>NE 1/4 of NE 1/4</u>	<u>5</u>	
"	"	<u>17</u>	<u>SE 1/4 of NE 1/4</u>	<u>7</u>	
"	"	<u>17</u>	<u>NE 1/4 of SE 1/4</u>	<u>9</u>	
"	"	<u>16</u>	<u>NW 1/4 of NW 1/4</u>	<u>40</u>	
"	"	<u>16</u>	<u>SW 1/4 of NW 1/4</u>	<u>38</u>	
"	"	<u>16</u>	<u>NW 1/4 of SW 1/4</u>	<u>30</u>	
"	"	<u>16</u>	<u>NE 1/4 of NW 1/4</u>	<u>3</u>	
"	"	<u>9</u>	<u>SE 1/4 of SW 1/4</u>	<u>3</u>	
				<u>142.5</u>	

15. If the ground water supply is supplemental to an existing water supply, identification of any application for a permit, permit, certificate or adjudicated right to appropriate water made or held by the registrant.

Township 55 Range 2W, W.M.

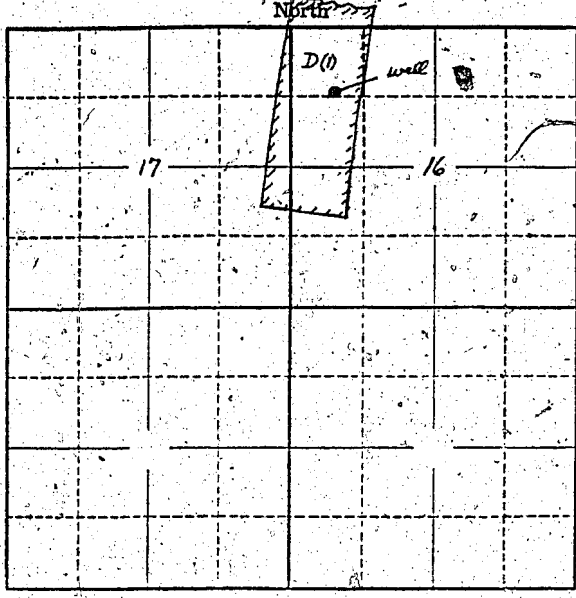

Locate well and acreage of irrigated land on plat.  
Scale: 2" = 1 Mile

STATE OF OREGON }  
County of Marion } ss.

I, \_\_\_\_\_, being first duly sworn, do hereby certify that I have read the foregoing Registration Statement and that all of the items therein contained are true to the best of my knowledge and belief.

James E. Hanson  
(Signature of Registrant)

Subscribed and sworn to before me this 20th day of February, 1958

My commission expires 12th June 1961 Wm. D. Balthasar  
(Notary Public)

(SEAL)

**CERTIFICATE OF REGISTRATION**

STATE OF OREGON }  
County of Marion } ss.

This is to certify that the foregoing Registration Statement was received in the office of the State Engineer on the 24th day of February, 1958, at 11:00 o'clock A. M. and has been duly recorded in said office in Book No. 5 of Registration Statements on page GR-1019 C

Witness my hand this 30th day of June, 1958  
Lewis A. Stanley  
(State Engineer)

By \_\_\_\_\_  
(Deputy)