RECEIVED
FEB 13 1958
STATE ENGINEER
SALEM, OREGON

REGISTRATION NO. GR-1059

Registration Statement

CERTIFICATE NO. GR-1021

OF CLAIMANT OF RIGHT TO APPROPRIATE GROUND WATER

(Under Chapter 708, Oregon Laws 1955.)

TO THE STATE ENGINEER OF OREGON:

I, DWIGHT FEULNER,

of EUGENE County of LANE

State of OREGON, do hereby make application for a certificate of registration as evidence of a right to appropriate ground water.

1. **Source** from which water is withdrawn is PUMP 2 INCH (Flowing well, pump well, infiltration trench, or tunnel)

2. **Location** is: 3½ MILES N.W. of COBURG ORE. (Approximate distance and direction from nearest city or town);

and is more particularly described as follows: 750 feet north &

(a) 2375 FT EAST FROM S.W. SECT. ON CORNER IN WELL (Give distance and bearing to corner of section or other legal subdivision)

being within SE¼ of SW¼ (Smallest legal subdivision) of Sec. 18, Twp. 16 S (N. or S.), Rge. 3 W (E. or W.).

or (b) within limits of recorded platted property, town or city:

in Lot ....., Block ..... of ..... (Name of plat or addition)

..... (If within city or town, give name) County of .....

3. **Construction Work** was begun on LATE OCT. 1952 (Date); was completed on OCT 1ST 1952 (Date)

and the ground water claimed was first used for the purposes set out below on JULY 24TH 1953 (Date)

since which time the water has been used INTERMITTENTLY (Continuously or intermittently)

from JUNE 1 (Date) to OCT. 1957 (Date)

4. **Quantity** of water claimed and used is 160 gallons per minute; 13 acre feet per year.

5. **Purpose or Purposes** for which water is used IRRIGATE PASTURE DOMESTIC (Domestic, irrigation, municipal, manufacturing, industrial, etc.)

6. **Description of Well:** Depth 40' feet. Type DRILLED (Dug or drilled)

diameter 6" inches. Elevation of ground at well site 363 (As near as known) feet, mean sea level.

Depth to water table 8 feet.

7. **Capacity of Well:** 160 g.p.m. with 3' feet drawdown.

..... g.p.m. with ..... feet drawdown.

Date of test NEVER TEST

If Flowing Well: Measured discharge ..... g.p.m. on ..... (Date)

Shut-in pressure at ground surface ..... lbs. per sq. in. on ..... (Date)

Water is controlled by ..... (Cap, valve, etc.)

8. **Casing:** (Give diameter, commercial specifications and depth below ground surface of each casing size.)

6" inch diameter PIPE. from 0 to 40 feet

..... inch diameter ..... from ..... to ..... feet

..... inch diameter ..... from ..... to ..... feet

..... inch diameter ..... from ..... to ..... feet

Describe and show depth of shoe, plug, adapter, liner or other details: .....

9. **Perforated Casings or Screens:**

26 or 30 (Number per foot and size of perforations, or describe screen) from 10 ft to 40 ft.

..... from ..... to .....

..... from ..... to .....

..... from ..... to .....

10. **Log of Well:** (Describe each stratum or formation clearly, indicate if water bearing, and give thickness and depth as indicated.)

MATERIAL	Thickness (Feet)	Depth to Bottom (Feet)
unknown		

GR-1021 A

If log of well is not available, give name and address of driller. WAYNE HAYES EUGENE ORE.

11. **Infiltration Trench:** Covered or open .....

Dimensions: Length ..... ft. Minimum depth ..... ft. Maximum depth ..... ft.

Bottom width ..... ft. Discharge ..... g.p.m. Date of test .....

12. **Tunnel:** Type of lining .....

Dimensions: ..... (Length, course, and cross sectional size)

Position of water bearing stratum with reference to portal of tunnel .....

Log of tunnel: (Preceding table for log of well may be used, if desired. Give footage from portal and character of materials, as pertinent.)

13. **Pumping Equipment:**

(a) Pump FAIRBANK MORIS (Make, type and size) Capacity 175 g.p.m.

(b) Motor 7½ HP 3 PHASE (Type and horsepower)

14. Location of area irrigated or to be irrigated, or place of use if for purposes other than irrigation.

Township North or South	Range E. or W. of Willamette Meridian	Section	Forty-acre Tract	Number Acres To Be Irrigated	Date of Reclamation
—					
T16S.	3W.	18	—	13 Total	1953
T16S	3W	18	NE¼ of SW¼	1°	"
"	"	"	SE¼ of SW¼	10°	"
"	"	"	SW¼ of SE¼	2°	"
				13° Total	"

15. If the ground water supply is supplemental to an existing water supply, identification of any application for a permit, permit, certificate or adjudicated right to appropriate water made or held by the registrant.

.....

.....

GR-1021 B

Township 16 S. Range 3 West W.M.

North

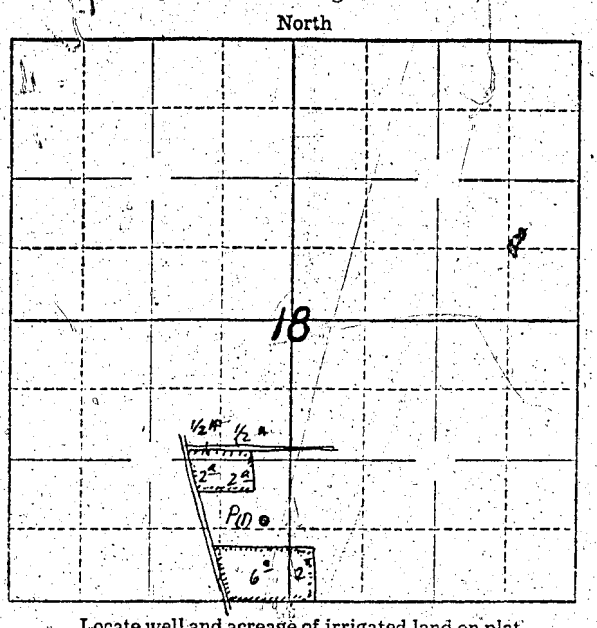

Locate well and acreage of irrigated land on plat.

Scale: 2" — 1 Mile

STATE OF OREGON
County of Lane } ss.

I, Dwight Feulner, being first duly sworn, do hereby certify that I have read the foregoing Registration Statement and that all of the items therein contained are true to the best of my knowledge and belief.

(Signature of Registrant)

Subscribed and sworn to before me this 21st day of February, 19 58.

My commission expires .....

(Notary Public)

(SEAL)

CERTIFICATE OF REGISTRATION

STATE OF OREGON
County of Marion } ss.

This is to certify that the foregoing Registration Statement was received in the office of the State Engineer on the 4th day of February, 19 58, at 4 o'clock P M. and has been duly recorded in said office in Book No. 5 of Registration Statements on page GR-1021 C

~~XXXX