

RECEIVED  
JUL 11 1950  
STATE ENGINEER  
SALEM OREGON

REGISTRATION NO. GR-101  
CERTIFICATE NO. GR-98

# Registration Statement

## OF CLAIMANT OF RIGHT TO APPROPRIATE GROUND WATER

(Under Chapter 708, Oregon Laws 1955.)

TO THE STATE ENGINEER OF OREGON:

I, Robert J. Cobine (Cobine & Cobine)

of Independence County of Polk

State of Oregon, do hereby make application for a certificate of registration as evidence of a right to appropriate ground water.

1. Source from which water is withdrawn is pump well #1  
(Flowing well, pump well, infiltration trench, or tunnel)

2. Location is: 6 1/2 miles South East of Independence  
(Approximate distance and direction from nearest city or town)

and is more particularly described as follows:

(a) 1430' - N 55° W from SE corner section 11  
(Give distance and bearing to corner of section or other legal subdivision)

being within SE 1/4 of SE 1/4 of Sec. 11, Twp. 9S, Rge. 4W  
(Smallest legal subdivision) (N or S) (E or W)

or (b) within limits of recorded platted property, town or city:

in Lot \_\_\_\_\_, Block \_\_\_\_\_ of \_\_\_\_\_  
(Name of plat or addition)

County of \_\_\_\_\_  
(If within city or town, give name)

3. Construction Work was begun on July 10 1950; was completed on July 18 1950  
(Date) (Date)

and the ground water claimed was first used for the purposes set out below on July 24 1950  
(Date)

since which time the water has been used Every year since  
(Continuously or intermittently)

from 1952 to 1956  
(Date) (Date)

4. Quantity of water claimed and used is 600 gallons per minute; 30 acre feet per year.

5. Purpose or Purposes for which water is used for irrigation of

farm crops  
(Domestic, irrigation, municipal, manufacturing, industrial, etc.)

6. Description of Well: Depth 25 feet. Type hand drilled  
(Dug or drilled)

diameter 10 inches. Elevation of ground at well site 140' feet, mean sea level.  
(As near as known)

Depth to water table 108' feet.

7. Capacity of Well: 600 g.p.m. with none feet drawdown.

\_\_\_\_\_ g.p.m. with \_\_\_\_\_ feet drawdown.

Date of test while irrigating - 1950

If Flowing Well: Measured discharge \_\_\_\_\_ g.p.m. on \_\_\_\_\_  
(Date)


Shut-in pressure at ground surface \_\_\_\_\_ lbs. per sq. in. on \_\_\_\_\_  
(Date)

Water is controlled by \_\_\_\_\_  
(Cap, valve, etc.)





Township 9 S Range A W, W.M.  
North

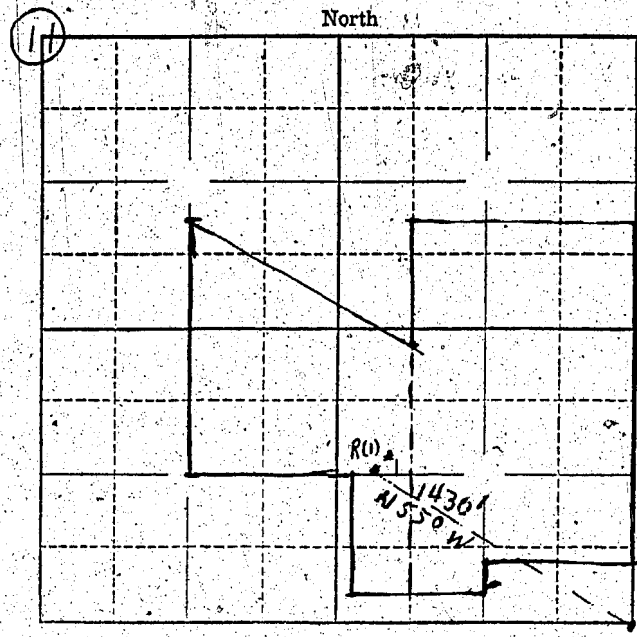

SE 1/4  
SEC-11

Locate well and acreage of irrigated land on plat.

Scale: 1" = 1 Mile  
8" = 1

STATE OF OREGON

County of \_\_\_\_\_ } ss.

I, \_\_\_\_\_, being first duly sworn, do hereby certify that I have read the foregoing Registration Statement and that all of the items therein contained are true to the best of my knowledge and belief.

*Robert J. Coburn*  
(Signature of Registrant)

Subscribed and sworn to before me this 17th day of September, 1956

My commission expires \_\_\_\_\_  
NOTARY PUBLIC FOR OREGON

\_\_\_\_\_  
(Notary Public)

(SEAL) My Commission Expires Jan. 27, 1959

**CERTIFICATE OF REGISTRATION**

STATE OF OREGON

County of Marion } ss.

For Certificate of Registration See page GR-98 G.

~~I do hereby certify that the foregoing Registration Statement was received in the office of the State Engineer on the \_\_\_\_\_ day of \_\_\_\_\_, 19\_\_\_\_, and has been duly recorded in accordance with the provisions of the Registration Statement on page \_\_\_\_\_.~~  
~~Construction shall be completed by \_\_\_\_\_ and the water completely applied to beneficial use by \_\_\_\_\_.~~

Witness my hand this \_\_\_\_\_ day of \_\_\_\_\_, 19\_\_\_\_.

\_\_\_\_\_  
(State Engineer)  
By \_\_\_\_\_  
(Deputy)

RECEIVED  
STATE ENGINEER  
SALES OFFICE

# Registration Statement

## OF CLAIMANT OF RIGHT TO APPROPRIATE GROUND WATER

(Under Chapter 708, Oregon Laws 1955.)

TO THE STATE ENGINEER OF OREGON:

I, Robert J. Cobine - et al - Cobine & Cobine  
of Independence County of Polk  
State of Oregon do hereby make application for a certificate of registration as evidence  
of a right to appropriate ground water.

- 1. Source from which water is withdrawn is Pump well #2  
(Pump well, pump well, infiltration trench, or tunnel)
- 2. Location is: Six and one half South East of Independence  
(Approximate distance and direction from nearest city or town)

and is more particularly described as follows:

(a) 10.60' N 30° W from SE corner section 11  
(Give distance and bearing to corner of section or other legal subdivision)  
being within SE 1/4 of SE 1/4 of Sec. 11, Twp. 9S, Rge. H W  
(Smallest legal subdivision) (N. or S.) (E. or W.)

or (b) within limits of recorded platted property, town or city:  
in Lot \_\_\_\_\_, Block \_\_\_\_\_ of \_\_\_\_\_  
(Name of plat or addition)  
County of \_\_\_\_\_  
(If within city or town, give name)

3. Construction Work was begun on July 8, was completed on July 18, 1950  
(Date) (Date)  
and the ground water claimed was first used for the purposes set out below on July 24, 1950  
(Date)  
since which time the water has been used Every year since  
(Continuously or intermittently)  
from 1950 to 1956  
(Date) (Date)

4. Quantity of water claimed and used is 600 gallons per minute; 56 acre  
feet per year.

5. Purpose or Purposes for which water is used for irrigation  
of farm crops  
(Domestic, irrigation, municipal, manufacturing, industrial, etc.)

6. Description of Well: Depth 32 feet. Type Drilled  
(Dug or drilled)  
diameter 10 inches. Elevation of ground at well site 140 feet, mean sea level.  
(As near as known)  
Depth to water table 17 feet.

7. Capacity of Well: 600 g.p.m. with none feet drawdown.  
\_\_\_\_\_ g.p.m. with \_\_\_\_\_ feet drawdown.

Date of test while irrigating - 1950

If Flowing Well: Measured discharge \_\_\_\_\_ g.p.m. on \_\_\_\_\_  
(Date)


Shut-in pressure at ground surface \_\_\_\_\_ lbs. per sq. in. on \_\_\_\_\_  
(Date)

Water is controlled by \_\_\_\_\_  
(Cap, valve, etc.)





Township 9S Range 4W W.M.  
North

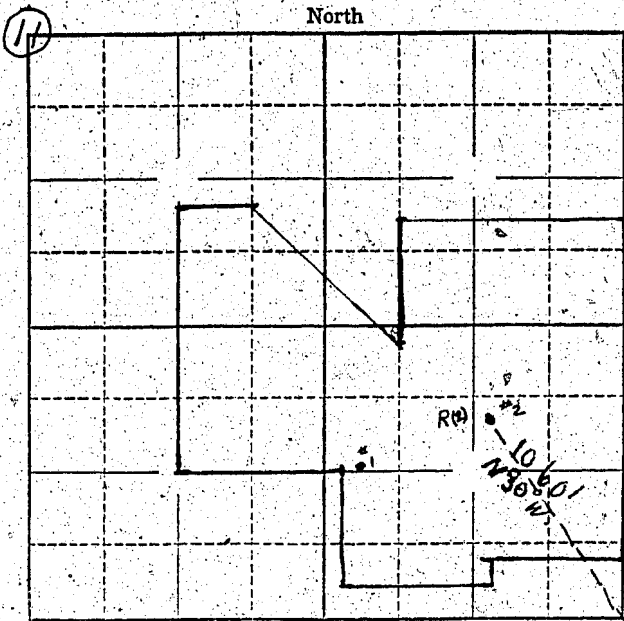

SE 1/4  
Sec-11

Locate well and acreage of irrigated land on plat.

Scale: 1" = 1 Mile  
8" = 1 "

STATE OF OREGON

County of \_\_\_\_\_ } ss.

I, Robert J. Cabine, being first duly sworn, do hereby certify that I have read the foregoing Registration Statement and that all of the items therein contained are true to the best of my knowledge and belief.

Robert J. Cabine  
(Signature of Registrant)

Subscribed and sworn to before me this 11th day of February, 1956

My commission expires \_\_\_\_\_  
My Commission Expires Jan. 27, 1956

[Signature]  
(Notary Public)

(SEAL)

**CERTIFICATE OF REGISTRATION**

STATE OF OREGON }  
County of Marion } ss.

This is to certify that the foregoing Registration Statement was received in the office of the State Engineer on the 9th day of February, 1956, at 8:00 o'clock A. M. and has been duly recorded in said office in Book No. 1 of Registration Statements on page GR-98G

~~Construction shall be completed by \_\_\_\_\_ and the order completely satisfied or~~  
~~revised by \_\_\_\_\_~~

Witness my hand this 12th day of April, 1956

[Signature]  
(State Engineer)

By \_\_\_\_\_  
(Deputy)