RECEIVED
FEB 1958
STATE ENGINEER
SALEM, OREGON

REGISTRATION NO. GR-1061

CERTIFICATE NO. GR-1023

Registration Statement

OF CLAIMANT OF RIGHT TO APPROPRIATE GROUND WATER

(Under Chapter 708, Oregon Laws 1955.)

TO THE STATE ENGINEER OF OREGON:

I, Harland E Fiddler,

of Hubbard R.F.D 378 County of Marion

State of Ore, do hereby make application for a certificate of registration as evidence of a right to appropriate ground water.

1. **Source** from which water is withdrawn is Pump well
(Flowing well, pump well, infiltration trench, or tunnel)

2. **Location** is: 1 mi S Donald
(Approximate distance and direction from nearest city or town)

and is more particularly described as follows:

(a) N84°13'E 41.15 Chs. From SW Corner Whiting D.C.L. #48
(Give distance and bearing to corner of section or other legal subdivision)

being within ~~SW¼ NE¼~~ SE¼ NE¼ ~~Sec.~~ of Sec. 19, Twp. 4 S (N. or S.), Rge. 1 W (E. or W.)
(Smallest legal subdivision)

or (b) within limits of recorded platted property, town or city:

in Lot ....., Block ....., of .....
(Name of plat or addition)

..... (If within city or town, give name) County of .....

3. **Construction Work** was begun on Aug 50 (Date); was completed on Aug 50 (Date)

and the ground water claimed was first used for the purposes set out below on Sept 50 (Date),

since which time the water has been used Intermittently (Continuously or intermittently)

from May (Date) to Nov (Date)

4. **Quantity** of water claimed and used is 40 gallons per minute; 15 acre feet per year.

5. **Purpose or Purposes** for which water is used Irrigation
(Domestic, irrigation, municipal, manufacturing, industrial, etc.)

6. **Description of Well:** Depth 120 feet. Type Drilled (Dug or drilled)

diameter 6 5/8 OD inches. Elevation of ground at well site 140? (As near as known) feet, mean sea level.

Depth to water table 45 feet.

7. **Capacity of Well:** 40 g.p.m. with 5 feet drawdown.

..... g.p.m. with ..... feet drawdown.

Date of test Aug 50

If Flowing Well: Measured discharge ..... g.p.m. on ..... (Date)

Shut-in pressure at ground surface ..... lbs. per sq. in. on ..... (Date)

Water is controlled by ..... (Cap, valve, etc.)

8. **Casing:** (Give diameter, commercial specifications and depth below ground surface of each casing size.)

6⅝" inch diameter Full Depth from 0 to 120 feet

_____ inch diameter _____ from _____ to _____ feet

_____ inch diameter _____ from _____ to _____ feet

_____ inch diameter _____ from _____ to _____ feet

Describe and show depth of shoe, plug, adapter, liner or other details: _____

9. **Perforated Casings or Screens:**

_____ from _____ to _____
(Number per foot and size of perforations, or describe screen)

_____ from _____ to _____

_____ from _____ to _____

_____ from _____ to _____

10. **Log of Well:** (Describe each stratum or formation clearly, indicate if water bearing, and give thickness and depth as indicated.)

MATERIAL	Thickness (Feet)	Depth to Bottom (Feet)
Top Soil	7	
Sub Soil	7-37	
Blue Shale	37-61	
Brown Shale fine Sand	61-65	
Sulfher Shale	65	
fine Sand	65-77	
Ruby Sand Coarse	77	
Sand "	77-82	
Yellow Clay	82-111	
Blue Shale	111-116	
Gravel Younger Alluvia (	116-121	

GR-1023 A

If log of well is not available, give name and address of driller. .....

.....

11. **Infiltration Trench:** Covered or open .....

Dimensions: Length ..... ft. Minimum depth ..... ft. Maximum depth ..... ft.

Bottom width ..... ft. Discharge ..... g.p.m. Date of test .....

12. **Tunnel:** Type of lining .....

Dimensions: .....
(Length, course, and cross sectional size)

Position of water bearing stratum with reference to portal of tunnel .....

.....

Log of tunnel: (Preceding table for log of well may be used, if desired. Give footage from portal and character of materials, as pertinent.)

13. **Pumping Equipment:**

(a) Pump Pacific Jet ..... Capacity 40 g.p.m.
(Make, type and size)

(b) Motor 3 HP 3 ph .....
(Type and horsepower)

14. Location of area irrigated or to be irrigated, or place of use if for purposes other than irrigation.

Township North or South	Range E. or W. of Willamette Meridian	Section	Forty-acre Tract	Number Acres To Be Irrigated	Date of Reclamation
4 S	1 W	19 ~~SE¼ NE¼~~	SE¼ NE¼	4.90	Sept. 1950
4 S	1 W	19	SW¼ NE¼	3.75	" "
4 S	1 W	19	NW¼ SE¼	1.55	" "
				10.20	

15. If the ground water supply is supplemental to an existing water supply, identification of any application for a permit, permit, certificate or adjudicated right to appropriate water made or held by the registrant.

.....

.....

GR-1023 B

Township 4S Range 1W, W.M.

North

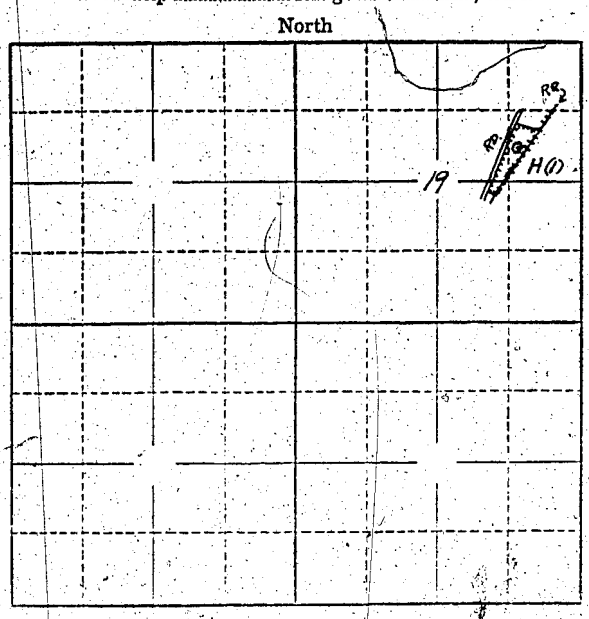

Locate well and acreage of irrigated land on plat.

Scale: 2" = 1 Mile

STATE OF OREGON)
County of Marion) ss.

I, Harland E. Feller, being first duly sworn, do hereby certify that I have read the foregoing Registration Statement and that all of the items therein contained are true to the best of my knowledge and belief.

Harland E Feller
(Signature of Registrant)

Subscribed and sworn to before me this 20th day of February, 1958.

My commission expires Sept. 8, 1960

(Notary Public)

(SEAL)

CERTIFICATE OF REGISTRATION

STATE OF OREGON)
County of Marion) ss.

This is to certify that the foregoing Registration Statement was received in the office of the State Engineer on the 21st day of February, 19 58, at o'clock M. and has been duly recorded in said office in Book No. 5 of Registration Statements on page GR-1023 C

Witness my hand this 30th day of June, 1958

(State Engineer)

By (Deputy)

GR-1023 C