

Registration Statement

OF CLAIMANT OF RIGHT TO APPROPRIATE GROUND WATER

TO THE STATE ENGINEER OF OREGON:

I, Robert L. Ormaclay
of 1250 River Loop NE County of Lane
(Mailing address)

State of Or, do hereby make application for a certificate of registration as evidence of a right to appropriate ground water.

1. Source from which water is withdrawn is well #2
(Flowing well, pump well, infiltration trench, or tunnel)

2. Location is: 6 mile from Eugene Ore
(Approximate distance and direction from nearest city or town)

and is more particularly described as follows:

(a) 1800' South 50' W of P.D. Dexter D.L.C #57
(Give distance and bearing to corner of section or other legal subdivision)

being within S.W. 1/4 of Sec. 1, Twp. 7 S, Rge. 4 W
(Smallest legal subdivision) (N. or S.) (E. or W.)

or (b) within limits of recorded platted property, town or city:

in Lot _____, Block _____ of _____
(Name of plat or addition)
County of Lane
(If within city or town, give name)

3. Construction Work was begun on 1940; was completed on 1940
(Date) (Date)

and the ground water claimed was first used for the purposes set out below on 1940
(Date)

since which time the water has been used Continuously
(Continuously or intermittently)

from 1940 to 1955
(Date) (Date)

4. Quantity of water claimed and used is 82 gallons per minute; 1500 ft per 500 acre feet per year.

5. Purpose or Purposes for which water is used Irrigation
domestic
(Domestic, irrigation, municipal, manufacturing, industrial, etc.)

6. Description of Well: Depth 20 feet. Type driven
(Dug or drilled)

diameter 2 1/2 inches. Elevation of ground at well site 200 feet, mean sea level.
(As near as known)

Depth to water table 10 feet.

7. Capacity of Well: _____ g.p.m. with _____ feet drawdown.

_____ g.p.m. with _____ feet drawdown.


Date of test not tested

If Flowing Well: Measured discharge _____ g.p.m. on _____
(Date)

Shut-in pressure at ground surface _____ lbs. per sq. in. on _____
(Date)

Water is controlled by _____
(Cap, valve, etc.)

Township 17 S Range 4 W, W.M.
North

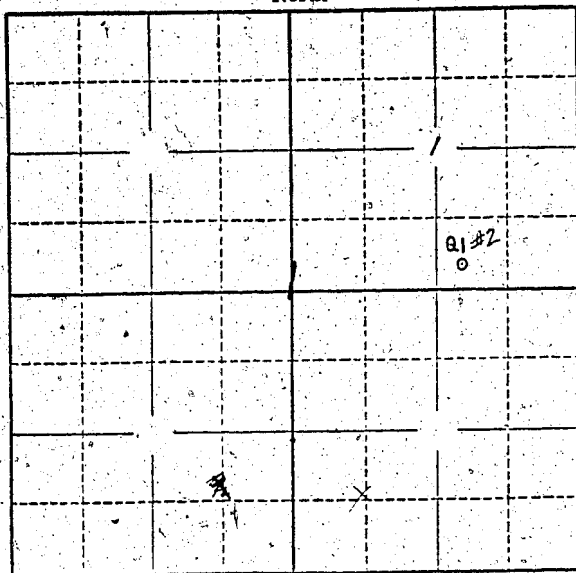

Locate well and acreage of irrigated land on plat.
Scale: 2" = 1 Mile

STATE OF OREGON

County of _____ } ss.

I, Robert D. MacLay, being first duly sworn, do hereby certify that I have read the foregoing Registration Statement and that all of the items therein contained are true to the best of my knowledge and belief.

Robert D. MacLay
(Signature of Registrant)

Subscribed and sworn to before me this 24th day of February, 19 58

My commission expires 12th June 1961

Wm. S. Bartholomew
(Notary Public)

(SEAL)

CERTIFICATE OF REGISTRATION

STATE OF OREGON

County of Marion } ss.

This is to certify that the foregoing Registration Statement was received in the office of the State Engineer on the 24th day of February, 19 58, at 12:00 o'clock 11 M. and has been duly recorded in said office in Book No. 5 of Registration Statements on page GR-1025C

Witness my hand this 30th day of June, 19 58

Lewis A. Stanley
(State Engineer)

By _____

(Deputy)

GR-1025 C