

Registration No. GR - 1065

Certificate No. GR - 1027

Registration Statement

OF CLAIMANT OF RIGHT TO APPROPRIATE GROUND WATER

TO THE STATE ENGINEER OF OREGON:

I, John Weiss
of Gervais Oregon County of Mason
(Mailing address)
State of Oregon, do hereby make application for a certificate of registration as evidence
of a right to appropriate ground water.

1. Source from which water is withdrawn is pump well
(Flowing well, pump well, infiltration trench, or tunnel)

2. Location is: 2 miles North of Gervais
(Approximate distance and direction from nearest city or town)

and is more particularly described as follows:

(a) 2500 feet east & 2200 feet north from SW corner section 14
(Give distance and bearing to corner of section or other legal subdivision)

being within NE 1/4 of SW 1/4 of Sec. 14, Twp. 5S, Rge. 2W
(Smallest legal subdivision) (N. or S.) (E. or W.)

or (b) within limits of recorded platted property, town or city:

in Lot _____, Block _____ of _____
(Name of plat or addition)

County of _____
(If within city or town, give name)

3. Construction Work was begun on Nov. 1947; was completed on Dec 1947
(Date) (Date)

and the ground water claimed was first used for the purposes set out below on June 1952
(Date)

since which time the water has been used Intermittently
(Continuously or Intermittently)

from spring 1952 to fall 1957
(Date) (Date)

4. Quantity of water claimed and used is 384 gallons per minute; 195 acre
feet per year.

5. Purpose or Purposes for which water is used IRRIGATION

(Domestic, irrigation, municipal, manufacturing, industrial, etc.)

6. Description of Well: Depth 137 feet. Type drilled
(Dug or drilled)

diameter 10" inches. Elevation of ground at well site 182 feet, mean sea level.
(As near as known)

Depth to water table 22 feet.

7. Capacity of Well: 500 g.p.m. with 45 feet drawdown;

_____ g.p.m. with _____ feet drawdown.

Date of test DEC. 1947

If Flowing Well: Measured discharge no g.p.m. on _____
(Date)

Shut-in pressure at ground surface _____ lbs. per sq. in. on _____
(Date)

Water is controlled by _____
(Cap, valve, etc.)

8. **Casing:** (Give diameter, commercial specifications and depth below ground surface of each casing size.)

10 inch diameter STEEL from 0 to 137 feet

inch diameter from to feet

inch diameter from to feet

inch diameter from to feet

Describe and show depth of shoe, plug, adapter, liner or other details: None

9. Perforated Casings or Screens:

25 ft Unknown from to
(Number per foot and size of perforations, or describe screen)

from to

from to

from to

from to

10. **Log of Well:** (Describe each stratum or formation clearly, indicate if water bearing, and give thickness and depth as indicated.)

[illegible]

If log of well is not available, give name and address of driller.

H.A. ROBINSON

CAPITAL CITY WELDING WORKS SALEM

11. Infiltration Trench: Covered or open

None

Dimensions: Length ft. Minimum depth ft. Maximum depth ft.

Bottom width ft. Discharge g.p.m. Date of test

12. Tunnel: Type of lining

None

Dimensions: (Length, course, and cross sectional size)

Position of water bearing stratum with reference to portal of tunnel

Log of tunnel: (Preceding table for log of well may be used, if desired. Give footage from portal and character of materials, as pertinent.)

13. Pumping Equipment:

(a) Pump

FA ~~████~~ BANKS-MORSE - TURBINE-8" BOWLS
Capacit

Capacity 400 g.p.m.

(b) Motor

20th


(Type and horsepower

14. Location of area irrigated or to be irrigated, or place of use if for purposes other than irrigation.

[illegible]

15. If the ground water supply is supplemental to an existing water supply, identification of any application for a permit, permit, certificate or adjudicated right to appropriate water made or held by the registrant.

Township 5S Range 2W W.M.
North

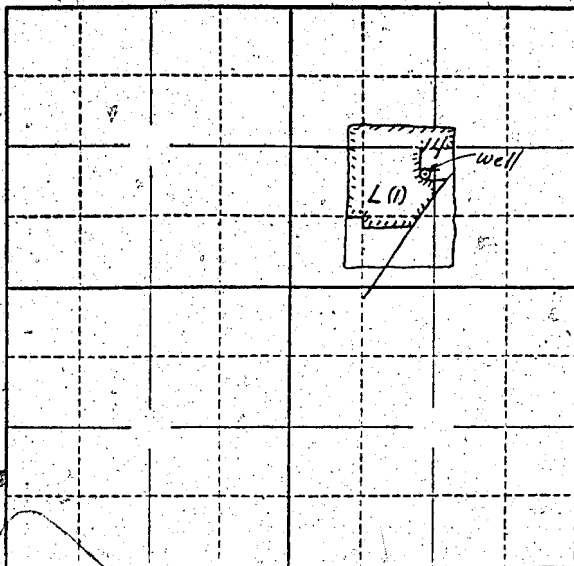

Locate well and acreage of irrigated land on plat.

Scale: 2" = 1 Mile

STATE OF OREGON

County of Marion Co. } ss.

I, _____, being first duly sworn, do hereby certify that I have read the foregoing Registration Statement and that all of the items therein contained are true to the best of my knowledge and belief.

John Heitz
(Signature of Registrant)

Subscribed and sworn to before me this 24th day of February, 1958

My commission expires 12th June 1961

Wm. S. Bartholomew
(Notary Public)

(SEAL)

CERTIFICATE OF REGISTRATION

STATE OF OREGON

County of Marion } ss.

This is to certify that the foregoing Registration Statement was received in the office of the State Engineer on the 24th day of February, 1958, at 1.15 o'clock P. M. and has been duly recorded in said office in Book No. 5 of Registration Statements on page GR-1027C

Witness my hand this 30th day of June, 1958

Leura A. Stanley
(State Engineer)

By _____

(Deputy)

GR - 1027 C