

Registration No. GR - 1066

Certificate No. GR - 1028

Registration Statement

OF CLAIMANT OF RIGHT TO APPROPRIATE GROUND WATER

TO THE STATE ENGINEER OF OREGON:

I, Leslie Brown
 of Rt. 1, Box 343 Silverton County of Marion
(Mailing address)
 State of Oregon, do hereby make application for a certificate of registration as evidence of a right to appropriate ground water.

1. Source from which water is withdrawn is pump well
(Flowing well, pump well, infiltration trench, or tunnel)
 2. Location is: 5 mi. S. Grant angel
(Approximate distance and direction from nearest city or town)

and is more particularly described as follows:

(a) 1750 feet E 100 feet north from NW corner Section 17
(Give distance and bearing to corner of section or other legal subdivision)
 being within Subty of Nelly of Sec. 17, Twp. 6S, Rge. 18
(smallest legal subdivision) (N. or S.) (E. or W.)
 or (b) within limits of recorded platted property, town or city:
 in Lot _____, Block _____ of _____
(Name of plat or addition)
 County of Marion
(If within city or town, give name)

3. Construction Work was begun on 1948; was completed on 1948
(Date) (Date)
 and the ground water claimed was first used for the purposes set out below on 1949 about 15 May
(Date)
 since which time the water has been used intermittently
(Continuously or intermittently)
 from May to November
(Date) (Date)

4. Quantity of water claimed and used is 75 gallons per minute; _____ acre
 feet per year.

5. Purpose or Purposes for which water is used irrigating
(Domestic, irrigation, municipal, manufacturing, industrial, etc.)

6. Description of Well: Depth 108 feet. Type Drilled
(Dug or drilled)
 diameter 6 inches. Elevation of ground at well site _____ feet, mean sea level.
(As near as known)
 Depth to water table 35 feet.

7. Capacity of Well: 75 g.p.m. with 3 feet drawdown.
 _____ g.p.m. with _____ feet drawdown.

Date of test _____
 If Flowing Well: Measured discharge _____ g.p.m. on _____
(Date)
 Shut-in pressure at ground surface _____ lbs. per sq. in. on _____
(Date)
 Water is controlled by _____
(Cap, valve, etc.)

8. Casing: (Give diameter, commercial specifications and depth below ground surface of each casing size.)

6 inch diameter steel casing from 0 to 17 feet
 inch diameter from to feet
 inch diameter from to feet
 inch diameter from to feet

Describe and show depth of shoe, plug, adapter, liner or other details:

9. Perforated Casings or Screens:

None from to
 (Number per foot and size of perforations, or describe screen)
 from to
 from to
 from to

10. Log of Well: (Describe each stratum or formation clearly, indicate if water bearing, and give thickness and depth as indicated.)

MATERIAL	Thickness (Feet)	Depth to Bottom (Feet)
Top soil	0	17
Basalt	17	108

If log of well is not available, give name and address of driller. A. Sladelli
Silverton Oregon

11. Infiltration Trench: Covered or open _____
 Dimensions: Length _____ ft. Minimum depth _____ ft. Maximum depth _____ ft.
 Bottom width _____ ft. Discharge _____ g.p.m. Date of test _____

12. Tunnel: Type of lining _____
 Dimensions: _____
(Length, course, and cross sectional size)
 Position of water bearing stratum with reference to portal of tunnel _____

Log of tunnel: (Preceding table for log of well may be used, if desired. Give footage from portal and character of materials, as pertinent.)


13. Pumping Equipment:
 (a) Pump Jacuzzi Jet Capacity 100 g.p.m.
(Make, type and size)
 (b) Motor J.C. Motor 5 H
(Type and horsepower)

14. Location of area irrigated or to be irrigated, or place of use if for purposes other than irrigation.

Township North or South	Range E. or W. of Willamette Meridian	Section	Forty-acre Tract	Number Acres To Be Irrigated	Date of Reclamation
T6S	1E	D7	SW 1/4 of NW 1/4	11.0	May 1949
"	"	"	NE 1/4 of SW 1/4	4.0	
				<u>15.0 Total</u>	

15. If the ground water supply is supplemental to an existing water supply, identification of any application for a permit, permit, certificate or adjudicated right to appropriate water made or held by the registrant.

Township 65 Range 24 W.M.
North

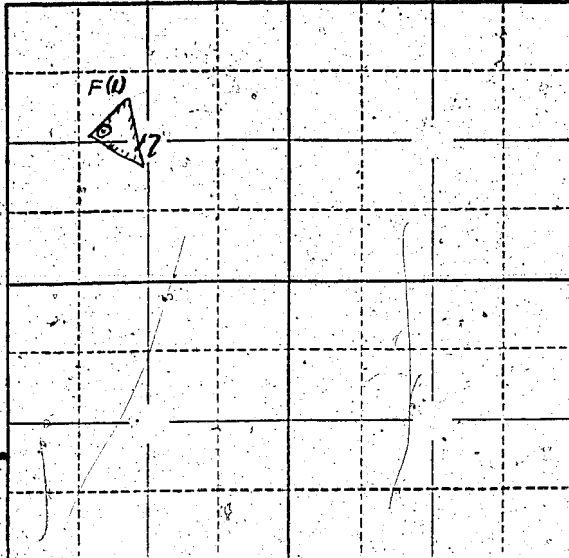

Locate well and acreage of irrigated land on plat.
Scale: 2" = 1 Mile

STATE OF OREGON

County of Marion } ss.

I, _____, being first duly sworn, do hereby certify that I have read the foregoing Registration Statement and that all of the items therein contained are true to the best of my knowledge and belief.

Leaie Brown
(Signature of Registrant)

Subscribed and sworn to before me this 24th day of February, 1958

My commission expires 12th June 1961 W.M. S. Bartholomew
(Notary Public)

(SEAL)

CERTIFICATE OF REGISTRATION

STATE OF OREGON

County of Marion } ss.

This is to certify that the foregoing Registration Statement was received in the office of the State Engineer on the 24th day of February, 1958, at 10:00 o'clock A.M. and has been duly recorded in said office in Book No. 5 of Registration Statements on page GR-1028C

Witness my hand this 30th day of June, 1958

Lewis A. Stanley
(State Engineer)

By _____
(Deputy)

GR-1028 C