

Registration No. GR - 1068

Certificate No. GR - 1030

Registration Statement

OF CLAIMANT OF RIGHT TO APPROPRIATE GROUND WATER

TO THE STATE ENGINEER OF OREGON:

I, Mrs Agnes K. Hawry
of Curmerville, Rt #1 Box 117 County of Marion
(Mailing address)
State of Oregon, do hereby make application for a certificate of registration as evidence
of a right to appropriate ground water.

1. Source from which water is withdrawn is Pump Well #1
(Flowing well, pump well, infiltration trench, or tunnel)
2. Location is: 1 1/4 MILE South East of West Stayton
(Approximate distance and direction from nearest city or town)

and is more particularly described as follows:

(a) 740 feet west and 1400 feet south from NE corner section 25
(Give distance and bearing to corner of section or other legal subdivision)
being within SE 1/4 of NE 1/4 of Sec. 25, Twp. 9S, Rge. 2W
(Smallest legal subdivision) (N. or S.) (E. or W.)
or (b) within limits of recorded platted property, town or city:
in Lot _____, Block _____ of _____
(Name of plat or addition)

(If within city or town, give name) County of _____

3. Construction Work was begun on May 10 1954; was completed on May 15 1954
(Date) (Date)
and the ground water claimed was first used for the purposes set out below on June 1954
(Date)
since which time the water has been used intermittently during season
(Continuously or intermittently)
from June 1954 to Sept 1957 no sprinkler is
(Date) (Date)

4. Quantity of water claimed and used is 300 gallons per minute; 8 acre
feet per year.

5. Purpose or Purposes for which water is used Irrigation

(Domestic, irrigation, municipal, manufacturing, industrial, etc.)

6. Description of Well: Depth 22 feet. Type Drilled
(Dug or drilled)
diameter 8 inches. Elevation of ground at well site 50 feet, mean sea level.
(as near as known)
Depth to water table 12 feet.

7. Capacity of Well: _____ g.p.m. with _____ feet drawdown.
_____ g.p.m. with _____ feet drawdown.

Date of test _____

If Flowing Well: Measured discharge _____ g.p.m. on _____
(Date)

Shut-in pressure at ground surface _____ lbs. per sq. in. on _____
(Date)

Water is controlled by _____
(Cap, valve, etc.)

..... inch diameter	<i>unknown</i>	from	to	feet
..... inch diameter		from	to	feet
..... inch diameter		from	to	feet
..... inch diameter		from	to	feet

9. Perforated Casings or Screens:

<i>4.4 Known</i> (Number per foot and size of perforations, or describe screen)	from	to
	from	to
	from	to
	from	to

10. **Log of Well:** (Describe each stratum or formation clearly, indicate if water bearing, and give thickness and depth as indicated.)

[illegible]

If log of well is not available, give name and address of driller. Mr. West of
SALEM, Oregon.

11. Infiltration Trench: Covered or open Covered

Dimensions: Length ft. Minimum depth ft. Maximum depth ft.

Bottom width ft. Discharge g.p.m. Date of test

12. Tunnel: Type of lining

Dimensions: _____
(Length, course, and cross sectional size).

Position of water bearing stratum with reference to portal of tunnel

Log of tunnel: (Preceding table for log of well may be used, if desired. Give footage from portal and character of materials, as pertinent.)

13. Pumping Equipment:

(a) Pump Centrifugal 3" Capacity 18,000 hr. g.p.m.
(Make, type and size)


(b) Motor Electric Motor 10 H. P.
(Type and horsepower)

14. Location of area irrigated or to be irrigated, or place of use if for purposes other than irrigation.

[illegible]

15. If the ground water supply is supplemental to an existing water supply, identification of any application for a permit, permit, certificate or adjudicated right to appropriate water made or held by the registrant.

Township 9S Range 2W, W.M.
North

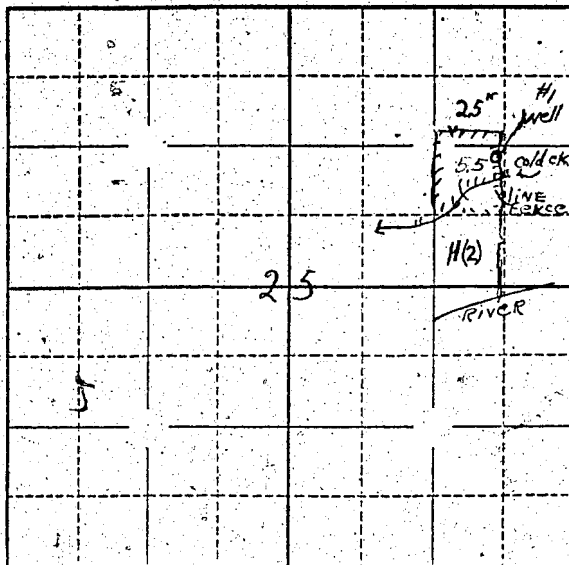

Locate well and acreage of irrigated land on plat.

Scale: 2" = 1 Mile

STATE OF OREGON

County of _____

ss.

I, Agnes K. Harvey, being first duly sworn, do hereby certify that I have read the foregoing Registration Statement and that all of the items therein contained are true to the best of my knowledge and belief.

AGNES K. HARVEY
(Signature of Registrant)

Subscribed and sworn to before me this 24th day of February, 1958

My commission expires 12th June 1961

Wm. S. Bartholomew
(Notary Public)

(SEAL)

CERTIFICATE OF REGISTRATION

STATE OF OREGON

County of Marion

ss.

This is to certify that the foregoing Registration Statement was received in the office of the State Engineer on the 24th day of February, 1958, at 3:00 o'clock P.M. and has been duly recorded in said office in Book No. 5 of Registration Statements on page GR-1030C

Witness my hand this 30th day of June, 1958

Lewis A. Stanley
(State Engineer)

By _____

(Deputy)

GR-1030C