

Registration Statement

OF CLAIMANT OF RIGHT TO APPROPRIATE GROUND WATER

(Under Chapter 708, Oregon Laws 1955.)

TO THE STATE ENGINEER OF OREGON:

I, Chester A and Wilma E. Varnes
of Rt. 1 Box 310 Turner, Oregon County of Marion

State of Oregon, do hereby make application for a certificate of registration as evidence of a right to appropriate ground water.

1. Source from which water is withdrawn is Pump Well
(Flowing well, pump well, infiltration trench, or tunnel)
2. Location is: 3 mi. South West of Turner, Oregon
(Approximate distance and direction from nearest city or town)

and is more particularly described as follows:

(a) 2293.37 feet South 79° 21' East from 4 section corner on west side of Sec. 6
(Give distance and bearing to corner of section or other legal subdivision)
being within N.E. 1/4 of South West 1/4 of Sec. 6, Twp. 9, Rge. 1 W
(Smallest legal subdivision) (N. or S.) (E. or W.)

or (b) within limits of recorded platted property, town or city: Sunny Side Fruit Farm # 5
in Lot _____, Block _____ of See Remarks
(Name of plat or addition)

County of Marion
(If within city or town, give name)

3. Construction Work was begun on 19 Jan 1950; was completed on 1 April 1950
(Date) (Date)

and the ground water claimed was first used for the purposes set out below on 1 June 1950
(Date)

since which time the water has been used Continuously
(Continuously or Intermittently)

from 1 June 1950 to _____ Date _____
(Date) (Date)

4. Quantity of water claimed and used is 45 gallons per minute; 72 acre feet per year.

5. Purpose or Purposes for which water is used irrigation of row crops
(Domestic, irrigation, municipal, manufacturing, industrial, etc.)

6. Description of Well: Depth 128.0' feet. Type Drilled
(Dug or drilled)
diameter 6" inches. Elevation of ground at well site 375.0 feet, mean sea level.
(As near as known)

Depth to water table 50 feet.

7. Capacity of Well: 45 g.p.m. with 10 feet drawdown.
_____ g.p.m. with _____ feet drawdown.

Date of test 1 April 1950

If Flowing Well: Measured discharge _____ g.p.m. on _____
(Date)

Shut-in pressure at ground surface _____ lbs. per sq. in. on _____
(Date)

Water is controlled by _____
(Cap, valve, etc.)

8. Casing: (Give diameter, commercial specifications and depth below ground surface of each casing size.)

6 inch diameter from Top to 128 feet
 inch diameter from to feet
 inch diameter from to feet
 inch diameter from to feet

Describe and show depth of shoe, plug, adapter, liner or other details:

.....

.....

9. Perforated Casings or Screens:

None from to
 (Number per foot and size of perforations, or describe screen)
 from to
 from to
 from to

10. Log of Well: (Describe each stratum or formation clearly, indicate if water bearing, and give thickness and depth as indicated.)

MATERIAL	Thickness (Feet)	Depth to Bottom (Feet)
Unknown an. rock		

If log of well is not available, give name and address of driller. Duffield Bros., 4045 Bluff Ave.,

Salem, Oregon

11. Infiltration Trench: Covered or open _____

Dimensions: Length _____ ft. Minimum depth _____ ft. Maximum depth _____ ft.

Bottom width _____ ft. Discharge _____ g.p.m. Date of test _____

12. Tunnel: Type of lining _____

Dimensions: _____
(Length, course, and cross sectional size)

Position of water bearing stratum with reference to portal of tunnel _____

Log of tunnel: (Preceding table for log of well may be used, if desired. Give footage from portal, and character of materials, as pertinent.)

13. Pumping Equipment:

(a) Pump Montgomery Ward, Jet, 262 Capacity 45 g.p.m.
(Make, type and size)

(b) Motor Electric 3/4 H.P.
(Type and horsepower)

14. Location of area irrigated or to be irrigated, or place of use if for purposes other than irrigation.


Township North or South	Range E. or W. of Willamette Meridian	Section	Portion of Tract	Number Acres To Be Irrigated	Date of Reclamation
9 S	1W	6	N.E. 1/4 S.W. 1/4	8.0	6/1/50
9 S	1W	6	N.W. 1/4 S.E. 1/4	25.0	"
9 S	1W	6	N.W. 1/4 S.E. 1/4	7.0	"
				40	

Legal Description

Lots 49 to 60 inclusive of Sunny Side Fruit Farms No. 5
 Lot 16 of Sunny Side Fruit Farms No. 5
 Lot 16 of Sunny Side Fruit Farms No. 5 except the southerly 10 acres thereof.
 Lot 17 of Sunny Side Fruit Farms No. 5 except the southerly 10 acres thereof.

15. If the ground water supply is supplemental to an existing water supply, identification of any application for a permit, permit, certificate or adjudicated right to appropriate water made or held by the registrant.

Township 9S Range 1W W.M.
North

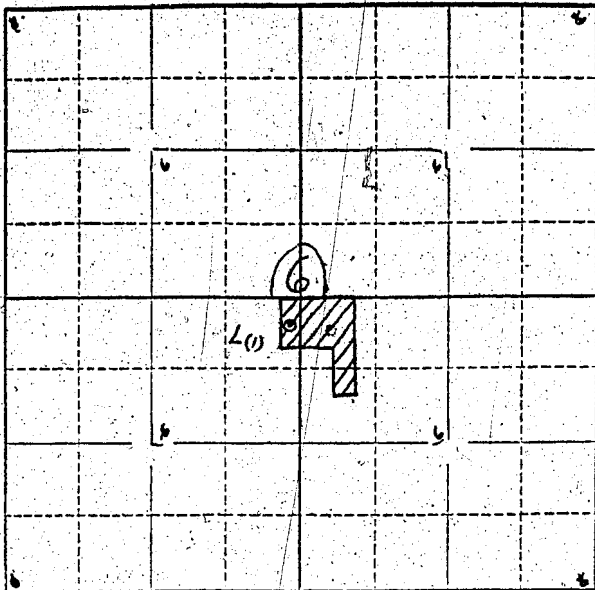

Locate well and acreage of irrigated land on plat.

Scale: $\frac{1}{2}$ " = 1 Mile

STATE OF OREGON

County of Marion } ss.

I, Chester A. Wilma E. Varnes, being first duly sworn, do hereby certify that I have read the foregoing Registration Statement and that all of the items therein contained are true to the best of my knowledge and belief.

[Signature]

(Signature of Registrant)

Subscribed and sworn to before me this 18th day of January, 19 56

My commission expires April 26, 1957 *[Signature]*

(Notary Public)

(SEAL)

CERTIFICATE OF REGISTRATION

STATE OF OREGON }
County of Marion } ss.

This is to certify that the foregoing Registration Statement was received in the office of the State Engineer on the 6th day of February, 1956, at 5:00 o'clock P. M. and has been duly recorded in said office in Book No. 2 of Registration Statements on page GR-271-C

~~Cost of this statement completed by X-X-X-X-X-X-X-X-X-X-X-X-X-X-X-X and the water completely applied to beneficial use by X-X-X-X-X-X-X-X-X-X-X-X-X-X-X-X~~

Witness my hand this 15th day of January, 19 57
[Signature]

(State Engineer)

By _____

(Deputy)