

Registration Statement

OF CLAIMANT OF RIGHT TO APPROPRIATE GROUND WATER

(Under Chapter 708, Oregon Laws 1955.)

TO THE STATE ENGINEER OF OREGON:

I, Virgil R. Hiebert and Anna Hiebert
of Quinn County of Mason Co
State of Oregon, do hereby make application for a certificate of registration as evidence of a right to appropriate ground water.

1. Source from which water is withdrawn is Sump #1
(Flowing well, pump well, infiltration trench, or tunnel)

2. Location is: 2200 ft East 1500 ft South of NW corner Section 32
(Approximate distance and direction from nearest city or town)

and is more particularly described as follows:

(a) 2350 feet east & 1400 feet south from NW corner Section 32
(Give distance and bearing to corner of section or other legal subdivision)

being within SE 1/4 & NW 1/4 of Sec. 32, Twp. 8 S Rge. 2 W
(Smallest legal subdivision) (N. or S.) (E. or W.)

or (b) within limits of recorded platted property, town or city:

in Lot _____, Block _____ of _____
(Name of plat or addition)

County of _____
(If within city or town, give name)

3. Construction Work was begun on September 1952; was completed on 1952
(Date) (Date)

and the ground water claimed was first used for the purposes set out below on September 1952
(Date)

since which time the water has been used Intermittently
(Continuously or Intermittently)

from Jan 1952 to Mar 1957
(Date) (Date)

4. Quantity of water claimed and used is 100 gallons per minute; _____ acre feet per year.

5. Purpose or Purposes for which water is used Irrigation
(Domestic, irrigation, municipal, manufacturing, industrial, etc.)

6. Description of Well: Depth 20 feet. Type Dug
(Dug or drilled)

diameter 24 inches. Elevation of ground at well site 290 feet, mean sea level.
(As near as known)

Depth to water table 4 feet. Summer

7. Capacity of Well: _____ g.p.m. with _____ feet drawdown.

_____ g.p.m. with _____ feet drawdown.

Date of test _____

If Flowing Well: Measured discharge _____ g.p.m. on _____
(Date)

Shut-in pressure at ground surface _____ lbs. per sq. in. on _____
(Date)

Water is controlled by _____
(Cap, valve, etc.)

8. Casing: (Give diameter, commercial specifications and depth below ground surface of each casing size.)

Sump
~~12~~ inch diameter ~~14~~ from ~~0~~ to ~~10~~ feet
inch diameter from to feet
inch diameter from to feet
inch diameter from to feet

Describe and show depth of shoe, plug, adapter, liner or other details: _____

9. Perforated Casings or Screens:

well
from to
(Number per foot and size of perforations, or describe screen)
from to
from to
from to

10. Log of Well: (Describe each stratum or formation clearly, indicate if water bearing, and give thickness and depth as indicated.)

MATERIAL	Thickness (Feet)	Depth to Bottom (Feet)
<i>well</i>		

GR-1039 A

If log of well is not available, give name and address of driller.

11. Infiltration Trench: Covered or open open
 Dimensions: Length 80 ft. Minimum depth 4 ft. Maximum depth 20 ft.

Bottom width 15 ft. Discharge 100 g.p.m. Date of test Nov 3, 1952

12. Tunnel: Type of lining

Dimensions:
(Length, course, and cross sectional size)

Position of water bearing stratum with reference to portal of tunnel

Log of tunnel: (Preceding table for log of well may be used, if desired. Give footage from portal and character of materials, as pertinent.)

13. Pumping Equipment:

(a) Pump Four banks - Morse Centrifugal Capacity 130 g.p.m.
(Make, type and size)


(b) Motor 7 1/2 HP Electric Motor
(Type and horsepower)

14. Location of area irrigated or to be irrigated, or place of use if for purposes other than irrigation.

Township North or South	Range E. or W. of Willamette Meridian	Section	Forty-acre Tract	Number Acres To Be Irrigated	Date of Reclamation
85	2W	32	NE 1/4 of NW 1/4	12	1952
85	"	32	SE 1/4 of NW 1/4	18	1952
				<u>30</u>	

15. If the ground water supply is supplemental to an existing water supply, identification of any application for a permit, permit, certificate or adjudicated right to appropriate water made or held by the registrant.

Township 8 S Range 2 W W.M.
North

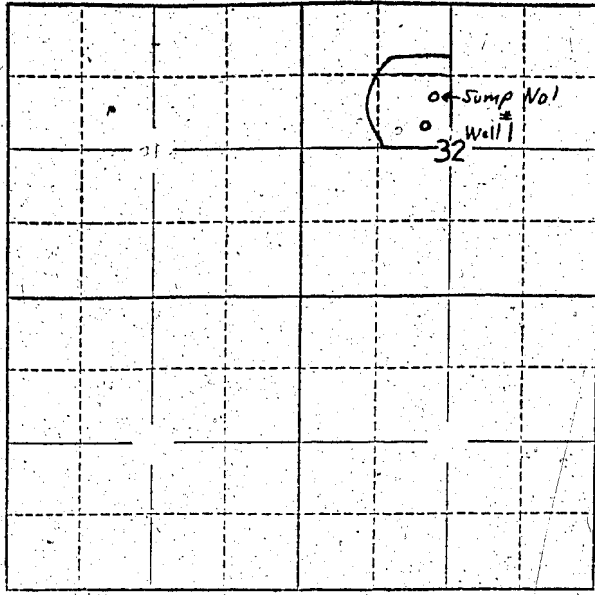

Locate well and acreage of irrigated land on plat.
Scale: 2" = 1 Mile

STATE OF OREGON }
County of Marion } ss.

I, _____, being first duly sworn, do hereby certify that I have read the foregoing Registration Statement and that all of the items therein contained are true to the best of my knowledge and belief.

Virgil P. Hetherington
(Signature of Registrant)

Subscribed and sworn to before me this 25th day of February, 1958.

My commission expires 12th June 1961 Wm. S. Bratholme
(Notary Public)

(SEAL)

CERTIFICATE OF REGISTRATION

STATE OF OREGON }
County of Marion } ss.

This is to certify that the foregoing Registration Statement was received in the office of the State Engineer on the 25th day of February, 1958, at 1:00 o'clock P.M. and has been duly recorded in said office in Book No. 6 of Registration Statements on page GP-1039C


Witness my hand this 30th day of June, 1958

Lewis A. Stanley
(State Engineer)

#15.00

By _____
(Deputy)

GR-1039 C