

Registration Statement

OF CLAIMANT OF RIGHT TO APPROPRIATE GROUND WATER

(Under Chapter 708, Oregon Laws 1955.)

TO THE STATE ENGINEER OF OREGON:

I, Virgil R. Hikethian and Anna Hikethian

of Clatsop County of Marion

State of Oregon, do hereby make application for a certificate of registration as evidence of a right to appropriate ground water.

1. Source from which water is withdrawn is Sumph # 2
(Flowing well, pump well, infiltration trench, or tunnel)

2. Location is: 16.00 ft East and 240.0 ft South of N.W. Corner Sec 32
(Approximate distance and direction from nearest city or town)

and is more particularly described as follows: Sumph in N.W. 1/4 Section 32

(a) 1250 feet east & 2050 feet south from NW corner Section 32
(Give distance and bearing to corner of section or other legal subdivision)

being within SW 1/4, NW 1/4 of Sec. 32, Twp. 8S, Rge. 2W
(Smallest legal subdivision) (N. or S.) (E. or W.)

or (b) within limits of recorded platted property, town or city:

in Lot _____, Block _____ of _____
(Name of plat or addition)

County of _____
(If within city or town, give name)

3. Construction Work was begun on September '52; was completed on 1952
(Date) (Date)

and the ground water claimed was first used for the purposes set out below on September 1952
(Date)

since which time the water has been used Intermittently
(Continuously or Intermittently)

from Sept. 1952 to Oct. 1957
(Date) (Date)

4. Quantity of water claimed and used is 100 gallons per minute; _____ acre feet per year.

5. Purpose or Purposes for which water is used Domestic
(Domestic, irrigation, municipal, manufacturing, industrial, etc.)

6. Description of Well: Depth _____ feet. Type _____
(Dug or drilled)
diameter _____ inches. Elevation of ground at well site 290 feet, mean sea level.
(As near as known)

Depth to water table 2 feet. Winter

7. Capacity of Well: None - g.p.m. with _____ feet drawdown.

_____ g.p.m. with _____ feet drawdown.


Date of test _____

If Flowing Well: Measured discharge _____ g.p.m. on _____
(Date)

Shut-in pressure at ground surface _____ lbs. per sq. in. on _____
(Date)

Water is controlled by _____
(C.C.P. valve, etc.)

Township 8.5 Range 2W W.M.
North

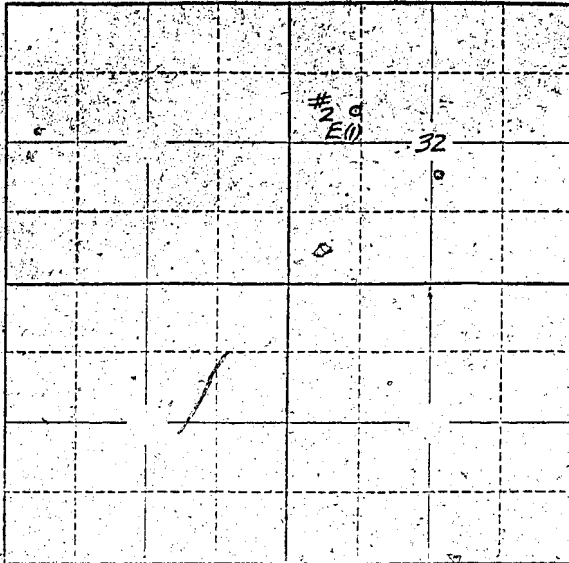

Locate well and acreage of irrigated land on plat.

Scale: 2" = 1 Mile

STATE OF OREGON

County of Marion ss:

I, Walter R. Durbath being first duly sworn, do hereby certify that I have read the foregoing Registration Statement and that all of the items therein contained are true to the best of my knowledge and belief.

Walter R. Durbath (Signature of Registrant) Anna Heister

Subscribed and sworn to before me this 25th day of February, 1958

My commission expires 12th June 1961 Wm. S. Bartholomew (Notary Public)

(SEAL)

CERTIFICATE OF REGISTRATION

STATE OF OREGON

County of Marion ss:

This is to certify that the foregoing Registration Statement was received in the office of the State Engineer on the 25th day of February, 1958, at 1:00 o'clock P. M. and has been duly recorded in said office in Book No. 5 of Registration Statements on page GR-1040C

Witness my hand this 30th day of June, 1958

Lewis A. Stanley (State Engineer)

By _____ (Deputy)

GR-1040C

15.00