

# Registration Statement

## OF CLAIMANT OF RIGHT TO APPROPRIATE GROUND WATER

(Under Chapter 708, Oregon Laws 1955.)

TO THE STATE ENGINEER OF OREGON:

I, HERMAN K. MUDER and LAUREL J. MUDER

of Dayton County of Yamhill

State of Oregon do hereby make application for a certificate of registration as evidence of a right to appropriate ground water.

1. Source from which water is withdrawn is Pump well  
(Flowing well, pump well, infiltration trench, or tunnel)

2. Location is: 1 1/2 miles south of Dayton  
(Approximate distance and direction from nearest city or town)

and is more particularly described as follows:

(a) 26 chains west and 4 chains north of S.E. corner Section 21  
(Give distance and bearing to corner of section or other legal subdivision)

being within SW 1/4 SE 1/4 of Sec. 21, Twp. 4 S., Rge. 3 W.  
(Smallest legal subdivision) (N. or S.) (E. or W.)

or (b) within limits of recorded platted property, town or city:

in Lot \_\_\_\_\_, Block \_\_\_\_\_ of \_\_\_\_\_  
(Name of plat or addition)

County of \_\_\_\_\_  
(If within city or town, give name)

3. Construction Work was begun on June 16, 1952; was completed on June 23, 1952  
(Date) (Date)

and the ground water claimed was first used for the purposes set out below on June 1952  
(Date)

since which time the water has been used continuously during irrigation season  
(Continuously or Intermittently)

from 1952 to 1955  
(Date) (Date)

4. Quantity of water claimed and used is 375 gallons per minute; 66 acre feet per year.

5. Purpose or Purposes for which water is used irrigation

(Domestic, irrigation, municipal, manufacturing, industrial, etc.)

6. Description of Well: Depth 150 feet. Type drilled  
(Dug or drilled)

diameter 8 inches. Elevation of ground at well site +163 feet, mean sea level.  
(As near as known)

Depth to water table 20 feet.

7. Capacity of Well: 375 g.p.m. with 135 feet drawdown.  
\_\_\_\_\_ g.p.m. with \_\_\_\_\_ feet drawdown.

Date of test June 20, 1952

If Flowing Well: Measured discharge \_\_\_\_\_ g.p.m. on \_\_\_\_\_  
(Date)


Shut-in pressure at ground surface \_\_\_\_\_ lbs. per sq. in. on \_\_\_\_\_  
(Date)

Water is controlled by \_\_\_\_\_  
(Cap, valve, etc.)





Township 4S Range E 3 W, W.M.  
North

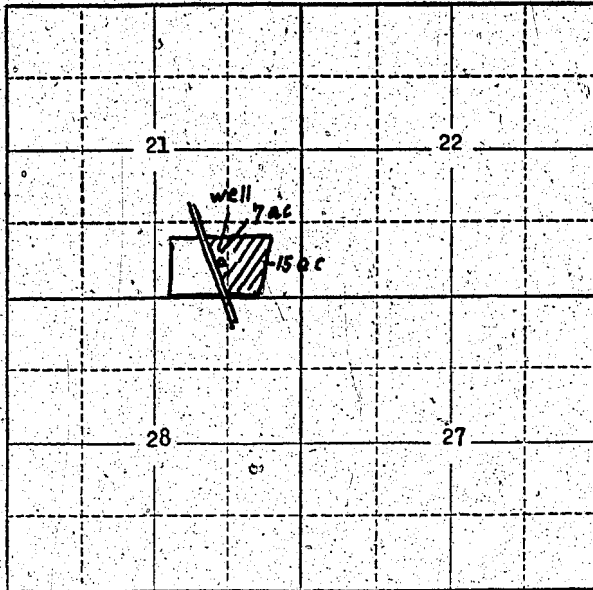

Locate well and acreage of irrigated land on plat.  
Scale: 2" = 1 Mile

STATE OF OREGON

County of Marion

ss.

I, HERMAN K. & LAUREL J. MUDER, being first duly sworn, do hereby certify that I have read the foregoing Registration Statement and that all of the items therein contained are true to the best of my knowledge and belief.

x Herman K. Muder  
x Laurel J. Muder  
(Signature of Registrant)

Subscribed and sworn to before me this 11th day of February, 1956

My commission expires Sept. 11, 1957

Lerna E. Davis  
(Notary Public)

(SEAL)

**CERTIFICATE OF REGISTRATION**

STATE OF OREGON

County of Marion

ss.

This is to certify that the foregoing Registration Statement was received in the office of the State Engineer on the 11th day of February, 1956, at 1:00 o'clock P.M. and has been duly recorded in said office in Book No. 1 of Registration Statements on page GR-99C

~~Construction shall be completed by \_\_\_\_\_ and the owner shall be responsible for~~  
~~maintaining the same by \_\_\_\_\_~~

Witness my hand this 12th day of April, 1956

Lewis A. Ottenley  
(State Engineer)

By \_\_\_\_\_  
(Deputy)

GR-99 C