

Registration Statement

OF CLAIMANT OF RIGHT TO APPROPRIATE GROUND WATER

TO THE STATE ENGINEER OF OREGON:

I, Valentine Miller
of Rt. 1 Box 87 Brooks County of Marion
(Mailing address)

State of Oregon, do hereby make application for a certificate of registration as evidence of a right to appropriate ground water.

1. Source from which water is withdrawn is Pump well
(Flowing well, pump well, infiltration trench, or tunnel)

2. Location is: 2 1/2 miles S.E. of Garwin
(Approximate distance and direction from nearest city or town)

and is more particularly described as follows:

(a) 950 feet east & 1760 feet south from NW corner Section 1,
(Give distance and bearing to corner of section or other legal subdivision)

being within S.W. 1/4 of NW 1/4 of Sec. 1 Twp. 6S Rge. 2W
(Smallest legal subdivision) (or S.) (or W.)

or (b) within limits of recorded platted property, town or city:

in Lot _____, Block _____ of _____
(Name of plat or addition)

County of Marion
(If within city or town, give name)

3. Construction Work was begun on Feb. 1955 was completed on April 1955
(Date) (Date)

and the ground water claimed was first used for the purposes set out below on June 1955
(Date)

since which time the water has been used Intermittently
(Continuously or intermittently)

from May 1955 to Sept. 1957
(Date) (Date)

4. Quantity of water claimed and used is 350 gallons per minute; 300 acre feet per year.

5. Purpose or Purposes for which water is used Irrig.
(Domestic, irrigation, municipal, manufacturing, industrial, etc.)

6. Description of Well: Depth 156 feet. Type Drilled
(Dug or drilled)

diameter 12 inches. Elevation of ground at well site 175 feet, mean sea level.
(As near as known)

Depth to water table 18 feet.

7. Capacity of Well: 640 g.p.m. with 29 feet drawdown.

_____ g.p.m. with _____ feet drawdown.


Date of test April 1955

If Flowing Well: Measured discharge 70 g.p.m. on _____
(Date)

Shut-in pressure at ground surface _____ lbs. per sq. in. on _____
(Date)

Water is controlled by _____
(Cap. valve, etc.)

Township 6 S Range 2 W, W.M.
North

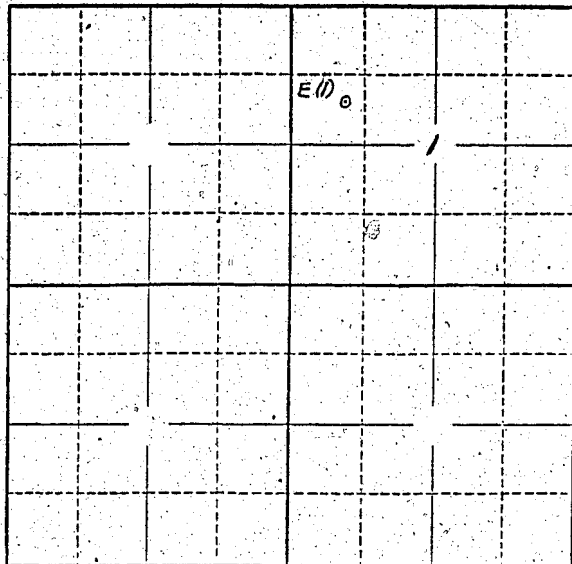

Locate well and acreage of irrigated land on plat.
Scale: 2" = 1 Mile

STATE OF OREGON

County of Marion

} ss.

I, Valentine Miller, being first duly sworn, do hereby certify that I have read the foregoing Registration Statement and that all of the items therein contained are true to the best of my knowledge and belief.

Valentine Miller
(Signature of Registrant)

Subscribed and sworn to before me this 25 day of February, 1958.

My commission expires Sept 22-1958

Chas. H. Ham
(Notary Public)

(SEAL)

CERTIFICATE OF REGISTRATION

STATE OF OREGON

County of Marion

} ss.

This is to certify that the foregoing Registration Statement was received in the office of the State Engineer on the 25th day of February, 1958, at 12:00 o'clock A. M. and has been duly recorded in said office in Book No. 5 of Registration Statements on page GR-1042C

Witness my hand this 30th day of June, 1958.

Lewis A. Stanley
(State Engineer)

By

(Deputy)

GR - 1042 C