

Registration Statement

OF CLAIMANT OF RIGHT TO APPROPRIATE GROUND WATER

TO THE STATE ENGINEER OF OREGON:

I, Ethan and/or Edith Hull

of Rt. 2, Box 199, Lebanon
(Mailing address)

County of Linn

State of Oregon, do hereby make application for a certificate of registration as evidence of a right to appropriate ground water:

1. Source from which water is withdrawn is pump well
(Flowing well, pump well, infiltration trench, or tunnel)
2. Location is: 4 miles NE of Lebanon, Oregon
(Approximate distance and direction from nearest city or town)

and is more particularly described as follows:

(a) S. 41° 40' E. 9.3 chains from NW corner of S. 36, T. 11 S., R. 2 W.
(Give distance and bearing to corner of section or other legal subdivision)
being within NW 1/4 of NW 1/4 of Sec. 36, Twp. 11 S, Rge. 2 W
(Smallest legal subdivision) (N. or S.) (E. or W.)

or (b) within limits of recorded platted property, town or city:
in Lot _____, Block _____ of _____
(Name of plat or addition)

County of Linn
(If within city or town, give name)

3. Construction Work was begun on Sept. 20, 1952; was completed on Sept. 23, 1952
(Date) (Date)

and the ground water claimed was first used for the purposes set out below on May 1953
(Date)

since which time the water has been used continuously
(Continuously or Intermittently)

from May 1953 to present time
(Date) (Date)

4. Quantity of water claimed and used is 300 gallons per minute; 117.5 acre feet per year.

5. Purpose or Purposes for which water is used Irrigation

(Domestic, irrigation, municipal, manufacturing, industrial, etc.)

6. Description of Well: Depth 23 feet. Type Drilled
(Dug or drilled)
diameter 8 inches. Elevation of ground at well site 315 feet, mean sea level.
(As near as known)
Depth to water table 13 feet.

7. Capacity of Well: 330 g.p.m. with 6 feet drawdown.
 g.p.m. with feet drawdown.

Date of test Sept. 23, 1952

If Flowing Well: Measured discharge g.p.m. on
(Date)

Shut-in pressure at ground surface lbs. per sq. in. on
(Date)

Water is controlled by
(Cap. valve, etc.)

8. Casing: (Give diameter, commercial specifications and depth below ground surface of each casing size.)

8 inch diameter steel casing from 0 to 23 feet
 8 inch diameter from to feet
 inch diameter from to feet
 inch diameter from to feet

Describe and show depth of shoe, plug, adapter, liner or other details:

9. Perforated Casings or Screens:

Slot perforations from 13 to 23
 (Number per foot and size of perforations, or describe screen)
 from to
 from to
 from to

10. Log of Well: (Describe each stratum or formation clearly, indicate if water bearing, and give thickness and depth as indicated.)

MATERIAL	Thickness (Feet)	Depth to Bottom (Feet)
Not available		

If log of well is not available, give name and address of driller. R. C. Gallatly, Box 811, Philomath, Oregon

11. Infiltration Trench: Covered or open

Dimensions: Length ft. Minimum depth ft. Maximum depth ft.

Bottom width ft. Discharge g.p.m. Date of test

12. Tunnel: Type of lining

Dimensions:
(Length, course, and cross sectional size)

Position of water bearing stratum with reference to portal of tunnel

Log of tunnel: (Preceding table for log of well may be used, if desired. Give footage from portal and character of materials, as pertinent.)

13. Pumping Equipment:

(a) Pump Gould 2" centrifugal Capacity 350 g.p.m.
(Make, type and size)

(b) Motor 15 H. P. electric
(Type and horsepower)


14. Location of area irrigated or to be irrigated, or place of use if for purposes other than irrigation.

Township North or South	Range E. or W. of Willamette Meridian	Section	Forty-acre Tract	Number Acres To Be Irrigated	Date of Reclamation
11 S	2 W	36	NW $\frac{1}{4}$ of NW $\frac{1}{4}$	30.0	May 1953
11 S	2 W	36	NE $\frac{1}{2}$ of NW $\frac{1}{4}$	13.0	" "
11 S	2 W	35	NE $\frac{1}{4}$ of NE $\frac{1}{4}$	16.0	" "
				<u>59.0</u>	

Linn State of Oregon, to-wit: Lot No. One in Section Thirtyfive, and Lot No. Two in Section Thirty-six, all in Township Eleven South, Range two west of the Will. Mer. in Linn County, Oregon, and containing 42.04 acres, more or less (also The South Half of the North half of the Northwest Quarter and The South Half of the Northwest quarter of the Northwest Quarter of Section Thirty-six in Township eleven South, Range Two west of the Will. Mer. in Linn County, State of Oregon, containing 30 acres, more or less. (also Pt. 6, Block 5 Mountain View Addition, Lebanon, Oregon.

15. If the ground water supply is supplemental to an existing water supply, identification of any application for a permit, permit, certificate or adjudicated right to appropriate water made or held by the registrant.

Township 11 S Range 2 W W.M. North

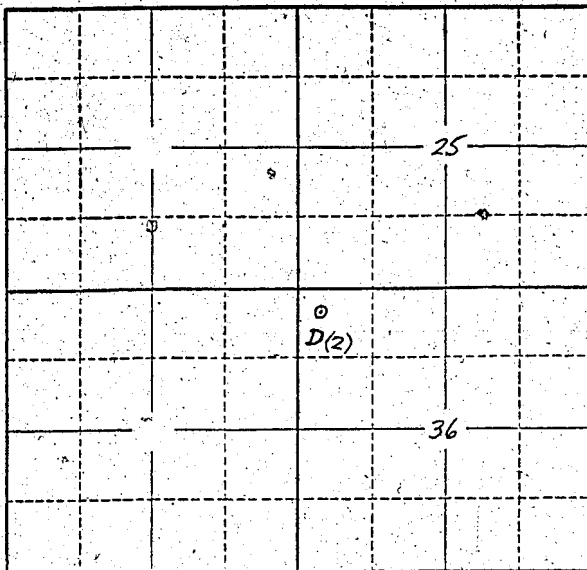

Locate well and acreage of irrigated land on plat.
Scale: 2" = 1 Mile

STATE OF OREGON

County of LINN

} ss.

I, Ethan and/or Edith Hull, being first duly sworn, do hereby certify that I have read the foregoing Registration Statement and that all of the items therein contained are true to the best of my knowledge and belief.

Edith J. Hull
Ethan Hull
(Signature of Registrant)

Subscribed and sworn to before me this 21st day of February, 1958

My commission expires July 13, 1958

Alta Wilson

(Notary Public)

(SEAL)

~~My Commission Expires~~

CERTIFICATE OF REGISTRATION

STATE OF OREGON

County of Marion

} ss.

This is to certify that the foregoing Registration Statement was received in the office of the State Engineer on the 26th day of February, 1958, at 6:00 o'clock A. M. and has been duly recorded in said office in Book No. 7 of Registration Statements on page GR-1401

Witness my hand this 20th day of October, 1958

Lewis A. Stanley
(State Engineer)

By _____ (Deputy)