

Registration Statement

OF CLAIMANT OF RIGHT TO APPROPRIATE GROUND WATER

TO THE STATE ENGINEER OF OREGON:

I, Lucile M. Strange
of Aurora RT. 1. Box 27 County of Marion
State of Oregon, do hereby make application for a certificate of registration as evidence of a right to appropriate ground water.

- 1. Source from which water is withdrawn is pump well
(Flowing well, pump well, infiltration trench, or tunnel)
- 2. Location is: 2 miles N.E. of Donald Ore
(Approximate distance and direction from nearest city or town)

and is more particularly described as follows:

(a) 600 FF W. E 440 FF N. from SE. COR Sec 9
(Give distance and bearing to corner of section or other legal subdivision)
being within SE 1/4 SE 1/4 of Sec. 9, Twp. 4 S, Rge. 1 W
(Smallest legal subdivision) (N. or S.) (E. or W.)

or (b) within limits of recorded-platted property, town or city:
in Lot _____, Block _____ of _____
(Name of plat or addition)

County of _____
(If within city or town, give name)

3. Construction Work was begun on Aug 20, 1954; was completed on Aug 23, 1954
(Date) (Date)
and the ground water claimed was first used for the purposes set out below on Aug 23, 1954
(Date)
since which time the water has been used continuously
(Continuously or intermittently)
from Aug 23, 1954 to Feb 20, 1958
(Date) (Date)

4. Quantity of water claimed and used is 100 gallons per minute; 37 acre feet per year.

5. Purpose or Purposes for which water is used IRRIGATION
(Domestic, irrigation, municipal, manufacturing, industrial, etc.)

6. Description of Well: Depth 75 feet. Type drilled
(Dug or drilled)
diameter 8 inches. Elevation of ground at well site 180 feet, mean sea level.
(As near as known)
Depth to water table unk. feet.

7. Capacity of Well: 100 g.p.m. with unk. feet drawdown.
_____ g.p.m. with _____ feet drawdown.


Date of test Aug 23, 1954

If Flowing Well: Measured discharge _____ g.p.m. on _____
(Date)

Shut-in pressure at ground surface _____ lbs. per sq. in. on _____
(Date)

Water is controlled by _____
(Cap, valve, etc.)

Township 45 Range 1 W. W.M.
North

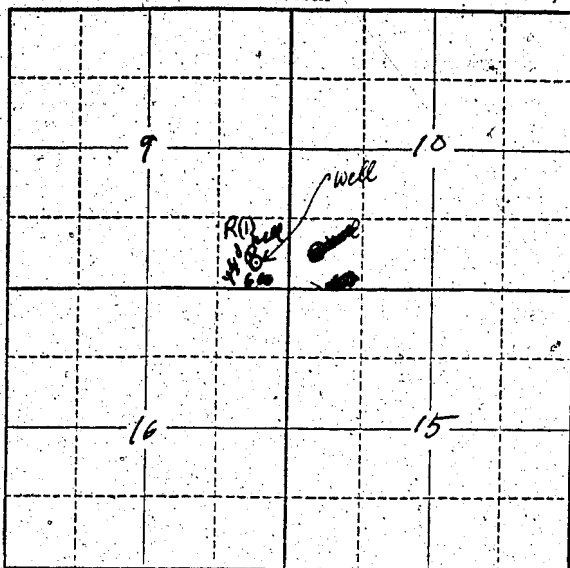

Locate well and acreage of irrigated land on plat.
Scale: 2" = 1 Mile

STATE OF OREGON

County of Marion

} ss.

I, _____, being first duly sworn, do hereby certify that I have read the foregoing Registration Statement and that all of the items therein contained are true to the best of my knowledge and belief.

Lucile M. Strange
(Signature of Registrant)

Subscribed and sworn to before me this 20th day of February, 19 56

My commission expires 12th June 1961

Wm. S. Bartholomew
(Notary Public)

(SEAL)

CERTIFICATE OF REGISTRATION

STATE OF OREGON

County of Marion

} ss.

This is to certify that the foregoing Registration Statement was received in the office of the State Engineer on the 26th day of February, 19 56, at 5:00 o'clock A. M. and has been duly recorded in said office in Book No. 5 of Registration Statements on page GR-1048 C

Witness my hand this 30th day of June, 19 58

Lewis A. Stanley
(State Engineer)

By _____

(Deputy)

GR-1048 C