

Registration Statement

OF CLAIMANT OF RIGHT TO APPROPRIATE GROUND WATER

TO THE STATE ENGINEER OF OREGON:

I, Chas. W. Kniss

of Silverton Rt 2, Box 181 County of Marion
(Mailing address)

State of Oregon, do hereby make application for a certificate of registration as evidence of a right to appropriate ground water.

1. Source from which water is withdrawn is pump well
(Flowing well, pump well, infiltration trench, or tunnel)

2. Location is: three miles west of Silverton
(Approximate distance and direction from nearest city or town)

and is more particularly described as follows:

(a) 67 chains East & 33 chains South from NW corner Sec. 31
(Give distance and bearing to corner of section or other legal subdivision)

being within SE 1/4 NE 1/4 of Sec. 31, Twp. 6S, Rge. 1W
(Smallest legal subdivision) (N. or S.) (E. or W.)

or (b) within limits of recorded platted property, town or city:

in Lot _____, Block _____ of _____
(Name of plat or addition)

County of _____
(If within city or town, give name)

3. Construction Work was begun on 1952; was completed on 1952
(Date) (Date)

and the ground water claimed was first used for the purposes set out below on May 1, 1952
(Date)

since which time the water has been used continuously during season
(Continuously or intermittently)

from May 1, 1952 to now
(Date) (Date)

4. Quantity of water claimed and used is 400 gallons per minute; _____ acre feet per year.

5. Purpose or Purposes for which water is used irrigation and stock

(Domestic, irrigation, municipal, manufacturing, industrial, etc.)

6. Description of Well: Depth 169 feet. Type drilled
(Dug or drilled)

diameter 12 inches. Elevation of ground at well site 198 feet, mean sea level.
(As near as known)

Depth to water table 32 feet.

7. Capacity of Well: 500 g.p.m. with 96 feet drawdown.

200 g.p.m. with 59 feet drawdown.

Date of test April 10, 1952

If Flowing Well: Measured discharge _____ g.p.m. on _____
(Date)

Shut-in pressure at ground surface _____ lbs. per sq. in. on _____
(Date)

Water is controlled by _____
(Cap. valve, etc.)

8. Casing: (Give diameter, commercial specifications and depth below ground surface of each casing size.)

12 inch diameter steel casing from 0 to 169 feet
 inch diameter from to feet
 inch diameter from to feet
 inch diameter from to feet

Describe and show depth of shoe, plug, adapter, liner or other details:

9. Perforated Casings or Screens:

Mill knife slots from to
 (Number per foot and size of perforations, or describe screen)
 5/16 x 1 1/4 two runs approximately 40 slots from 93 to 101
 5/16 x 1 1/4 40 slots from 138 to 146
 5/16 x 1 1/4 One run 20 from 152 to 160

10. Log of Well: (Describe each stratum or formation clearly, indicate if water bearing, and give thickness and depth as indicated.)

MATERIAL	Thickness (Feet)	Depth to Bottom (Feet)
Top soil	1-5	169'
Yellow clay	5-23	
Yellow and blue clay	23-36	
Yellow sandy clay	36-54	
Sand - a type of quick sand	54-71	
Cemented gravel	71-93	
Yellow filler with gravel (some water)	93-101	
Cemented gravel	101-138	
Loose gravel (water bearing gravel)	138-146	
Tight gravel	146-152	
Some water	152-160	
Tight cemented gravel	160-169	

If log of well is not available, give name and address of driller. HARRIS

11. Infiltration Trench: Covered or open _____

Dimensions: Length _____ ft. Minimum depth _____ ft. Maximum depth _____ ft.

Bottom width _____ ft. Discharge _____ g.p.m. Date of test _____

12. Tunnel: Type of lining _____

Dimensions: _____
(Length, course, and cross sectional size)

Position of water bearing stratum with reference to portal of tunnel _____

Log of tunnel: (Preceding table for log of well may be used, if desired. Give footage from portal and character of materials, as pertinent.)

13. Pumping Equipment:

(a) Pump Peerless turbine 4" Capacity 350 g.p.m.
(Make, type and size)


(b) Motor 10 H. P.
(Type and horsepower)

14. Location of area irrigated or to be irrigated, or place of use if for purposes other than irrigation.

Township North or South	Range E. or W. of Willamette Meridian	Section	Forty-acre Tract	Number Acres To Be Irrigated	Date of Reclamation
65	1W	31	SE $\frac{1}{4}$ NE $\frac{1}{4}$	29	1952
"	"	"	SW $\frac{1}{4}$ NE $\frac{1}{4}$	1	"
				30 ^e	

15. If the ground water supply is supplemental to an existing water supply, identification of any application for a permit, permit, certificate or adjudicated right to appropriate water made or held by the registrant.

Township 6S Range 1W W.M.
North

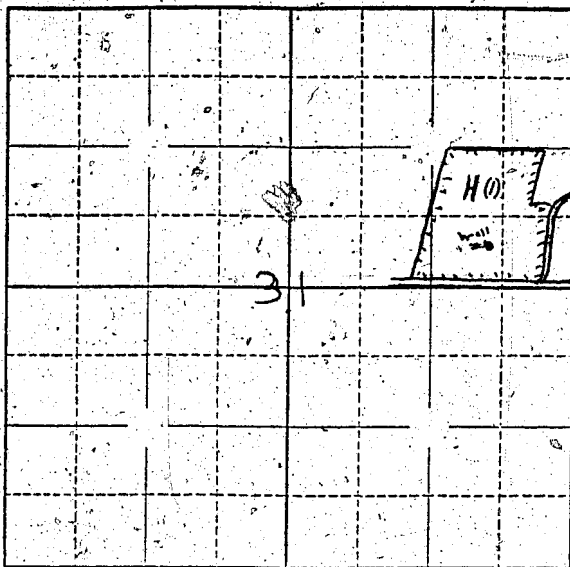

Locate well and acreage of irrigated land on plat.

Scale: $\frac{1}{4}$ - 1 Mile

STATE OF OREGON

County of Marion } ss.

I, Chas W. Kinnis, being first duly sworn, do hereby certify that I have read the foregoing Registration Statement and that all of the items therein contained are true to the best of my knowledge and belief.

Chas W. Kinnis
(Signature of Registrant)

Subscribed and sworn to before me this 26th day of February, 1958

My commission expires 12th June 1961

Wm. S. Bartholomew
(Notary Public)

(SEAL)

CERTIFICATE OF REGISTRATION

STATE OF OREGON

County of Marion } ss.

This is to certify that the foregoing Registration Statement was received in the office of the State Engineer on the 26th day of February, 1958, at 10:00 o'clock A. M. and has been duly recorded in said office in Book No. 5 of Registration Statements on page GR-1049 C

Witness my hand this 30th day of June, 1958.

Levin A. Stanley
(State Engineer)

By

(Deputy)

GR-1049 C