

RECEIVED

FEB 14 1956

STATE ENGINEER  
SALEM, OREGON

REGISTRATION NO. GR-109

CERTIFICATE NO. GR-100

Registration Statement

OF CLAIMANT OF RIGHT TO APPROPRIATE GROUND WATER

(Under Chapter 708, Oregon Laws 1955.)

TO THE STATE ENGINEER OF OREGON:

I, EMIL P. KRAFT

of Rt. 1, Box 56 - CANBY County of CLATSOP

State of OREGON, do hereby make application for a certificate of registration as evidence of a right to appropriate ground water.

1. Source from which water is withdrawn is PUMP WELL  
(Flowing well, pump well, infiltration trench, or tunnel)

2. Location is: 1 1/2 miles EAST of CANBY, OREGON  
(Approximate distance and direction from nearest city or town)

and is more particularly described as follows:

(a) N 52° 05' W, 2250 FEET from the SE Corner Sec. 34  
(Give distance and bearing to corner of section or other legal subdivision)

being within SE 1/4 NW 1/4 SE 1/4 of Sec. 34, Twp. 3S, Rge. 1E  
(Smallest legal subdivision) (N. or S.) (E. or W.)

or (b) within limits of recorded-platted property, town or city:

in Lot \_\_\_\_\_, Block \_\_\_\_\_ of \_\_\_\_\_  
(Name of plat or addition)

County of \_\_\_\_\_  
(If within city or town, give name)

3. Construction Work was begun on Nov. 13, 1944; was completed on Dec. 6, 1944  
(Date) (Date)

and the ground water claimed was first used for the purposes set out below on May, 1945  
(Date)

since which time the water has been used Intermittently  
(Continuously or Intermittently)

from May 1 to SEPT. 1 EACH YEAR  
(Date) (Date)

4. Quantity of water claimed and used is 200 gallons per minute; \_\_\_\_\_ acre feet per year.

5. Purpose or Purposes for which water is used IRRIGATION

(Domestic, irrigation, municipal, manufacturing, industrial, etc.)

6. Description of Well: Depth 12.5 feet. Type Drilled  
(Dug or drilled)

diameter 8" inches; Elevation of ground at well site 350 feet, mean sea level.  
(As near as known)

Depth to water table 50 feet.

7. Capacity of Well: 200 g.p.m. with 32 feet drawdown.

\_\_\_\_\_ g.p.m. with \_\_\_\_\_ feet drawdown.

Date of test MAY 1, 1955

If Flowing Well: Measured discharge \_\_\_\_\_ g.p.m. on \_\_\_\_\_  
(Date)


Shut-in pressure at ground surface \_\_\_\_\_ lbs. per sq. in. on \_\_\_\_\_  
(Date)

Water is controlled by \_\_\_\_\_  
(Cap, valve, etc.)





Township 3S Range 1E, W.M.  
North

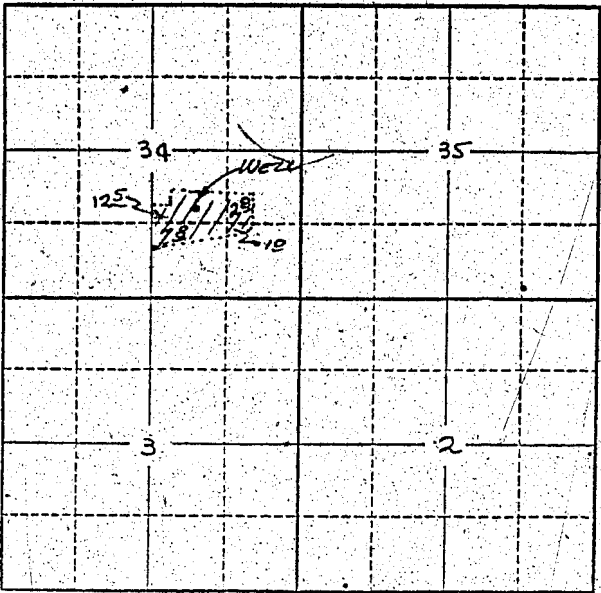

Locate well and acreage of irrigated land on plat.  
Scale: 2" = 1 Mile

STATE OF OREGON

County of \_\_\_\_\_ } ss.

I, \_\_\_\_\_, being first duly sworn, do hereby certify that I have read the foregoing Registration Statement and that all of the items therein contained are true to the best of my knowledge and belief.

*Emil P. Kraft*  
(Signature of Registrant)

Subscribed and sworn to before me this 9 day of February, 1956

My commission expires 2-18-1959 *H. J. Chestnut*  
(Notary Public)

(SEAL)

**CERTIFICATE OF REGISTRATION**

STATE OF OREGON

County of Marion } ss.

This is to certify that the foregoing Registration Statement was received in the office of the State Engineer on the 14th day of February, 1956, at 8:00 o'clock A. M. and has been duly recorded in said office in Book No. 1 of Registration Statements on page GR-1000.

~~Construction shall be completed by \_\_\_\_\_ and the water completely applied to \_\_\_\_\_~~  
~~\_\_\_\_\_~~

Witness my hand this 12th day of April, 1956

*Lewis A. Stanley*  
(State Engineer)

By \_\_\_\_\_  
(Deputy)