REGISTRATION NO. GR-1295

CERTIFICATE NO. GR-1056

Registration Statement

OF CLAIMANT OF RIGHT TO APPROPRIATE GROUND WATER

(Under Chapter 708, Oregon Laws 1955.)

TO THE STATE ENGINEER OF OREGON:

I, Mrs. Edna Elaine Allen,

of Rt. 1, Box 45, Aumsville County of Marion

State of Oregon, do hereby make application for a certificate of registration as evidence of a right to appropriate ground water.

1. **Source** from which water is withdrawn is Pumpwell (Flowing well, pump well/infiltration trench, or tunnel)

2. **Location** is: 1½ mi East Aumsville (Approximate distance and direction from nearest city or town);

and is more particularly described as follows:

(a) 940 feet west & 720 feet North from SE corner of Section 30 (Give distance and bearing to corner of section or other legal subdivision)

being within SE ¼ of SE ¼ (Smallest legal subdivision) of Sec. 30, Twp. 8 S (N. or S.), Rge. 1W (E. or W.)

or (b) within limits of recorded platted property, town or city:

in Lot ; Block of (Name of plat or addition)

(If within city or town, give name) County of

3. **Construction Work** was begun on 4-19-52 (Date); was completed on 5-2-52 (Date)

and the ground water claimed was first used for the purposes set out below on 7-1-54 (Date),

since which time the water has been used intermittently during season (Continuously or intermittently)

from 5-1-55 (Date) to 9-25-57 (Date).

4. **Quantity** of water claimed and used is 21 gals. gallons per minute; acre feet per year.

5. **Purpose or Purposes** for which water is used Irrigation

(Domestic, irrigation, municipal, manufacturing, industrial, etc.)

6. **Description of Well:** Depth 158 feet. Type Drilled (Dug or drilled)

diameter 8" to 123' 6" to 158' inches. Elevation of ground at well site 380 (As near as known) feet, mean sea level.

Depth to water table 123 feet.

7. **Capacity of Well:** 45 g.p.m. with 145 feet drawdown.

50 g.p.m. with Dry feet drawdown.

Date of test 11-[illegible]52

If Flowing W[illegible]ed discharge g.p.m. on (Date)

Shut-in pressu[illegible]nd surface lbs. per sq. in. on (Date)

Water is contro[illegible] (Cap, valve, etc.)

8. **Casing:** (Give diameter, commercial specifications and depth below ground surface of each casing size.)

8 inch diameter steel casing from 0 to 123 feet

6 inch diameter " " from 123 to 158 feet

inch diameter from to feet

inch diameter from to feet

Describe and show depth of shoe, plug, adapter, liner or other details:

9. **Perforated Casings or Screens:**

yes (Number per foot and size of perforations, or describe screen) from 35 to 123

from to

from to

from to

10. **Log of Well:** (Describe each stratum or formation clearly, indicate if water bearing, and give thickness and depth as indicated.)

MATERIAL	Thickness (Feet)	Depth to Bottom (Feet)
Basalt rock	123	156
Diorite rock (anilite)?	156	158

GR-1056 A

If log of well is not available, give name and address of driller. Carl Saunders.

11. **Infiltration Trench:** Covered or open .....

Dimensions: Length ..... ft. Minimum depth ..... ft. Maximum depth ..... ft.

Bottom width ..... ft. Discharge ..... g.p.m. Date of test .....

12. **Tunnel:** Type of lining .....

Dimensions: .....
(Length, course, and cross sectional size)

Position of water bearing stratum with reference to portal of tunnel .....

Log of tunnel: (Preceding table for log of well may be used, if desired. Give footage from portal and character of materials, as pertinent.)

13. **Pumping Equipment:**

(a) Pump Submersible (Make, type and size) Capacity 45 g.p.m.

(b) Motor Electric H.P. 1½ (Type and horsepower)

14. Location of area irrigated or to be irrigated, or place of use if for purposes other than irrigation.

Township North or South	Range E. or W. of Willamette Meridian	Section	Forty-acre Tract	Number Acres To Be Irrigated	Date of Reclamation
8S	1 West	30	SE¼ of SE¼	9	5-1-55

15. If the ground water supply is supplemental to an existing water supply, identification of any application for a permit, permit, certificate or adjudicated right to appropriate water made or held by the registrant.

.....

.....

GR-1056 B

SECTION 30

Township 8 S. Range 1 W, W.M.

North

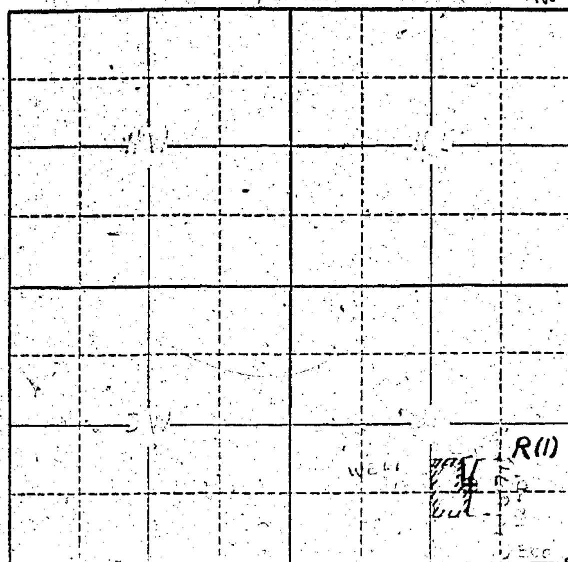

Locate well and acreage of irrigated land on plat.

Scale: 2" = 1 Mile

4

STATE OF OREGON }
County of Marion } ss.

I, ..., being first duly sworn, do hereby certify that I have read the foregoing Registration Statement and that all of the items therein contained are true to the best of my knowledge and belief.

Edna Elaine Allen

Samuel E. Allen.
(Signature of Registrant)

Subscribed and sworn to before me this 26th day of February, 1958.

My commission expires 12th June 1961 Wm. S. Bartholomew
(Notary Public)

(SEAL)

CERTIFICATE OF REGISTRATION

STATE OF OREGON }
County of Marion } ss.

This is to certify that the foregoing Registration Statement was received in the office of the State Engineer on the 26th day of February, 1958, at 5:00 o'clock P. M. and has been duly recorded in said office in Book No. 5 of Registration Statements on page GR-1056C

~~XXXXXXXXXXXXXXXXXXXXXXXXXXXXXXXXXXXXXXXXXXXXXXXXXXXXXXXXXXXXXXXXXX~~

~~XXXXXXXXXXXXXXXXXXXXXXXXXXXXXXXXX~~

Witness my hand this 30th day of June, 1958.

Lewis A. Stanley
(State Engineer)

15.00

By ....
(Deputy)

GR-1056 C