Registration No. GR - 1098

Certificate No. GR - 1059

Registration Statement

OF CLAIMANT OF RIGHT TO APPROPRIATE GROUND WATER

TO THE STATE ENGINEER OF OREGON:

Well # 3

I, Allison & Blacker Farms,

of Route 4 Box 314 Corvallis (Mailing address) County of Linn

State of Oregon, do hereby make application for a certificate of registration as evidence of a right to appropriate ground water.

1. **Source** from which water is withdrawn is pump well (Flowing well, pump well, infiltration trench, or tunnel)

2. **Location is:** two miles N.E. of Corvallis (Approximate distance and direction from nearest city or town);

and is more particularly described as follows:

(a) 670 feet N 79° W to section corner 30 & 31 T 11 S R 4 W (Give distance and bearing to corner of section or other legal subdivision)

being within NW 1/4 of NW 1/4 (Smallest legal subdivision) of Sec. 31, Twp. 11 S (N. or S.), Rge. 4 W (E. or W.)

or (b) within limits of recorded platted property, town or city: _____

in Lot _____, Block _____ of _____ (Name of plat or addition)

_____ (If within city or town, give name) County of _____

3. **Construction Work** was begun on May 1950 (Date); was completed on May 1950 (Date)

and the ground water claimed was first used for the purposes set out below on May 1950 (Date),

since which time the water has been used continuously every summer (Continuously or intermittently)

from 1950 (Date) to 1958 (Date)

4. **Quantity** of water claimed and used is 350 gallons per minute; 30 acre feet per year.

5. **Purpose or Purposes** for which water is used irrigation

(Domestic, irrigation, municipal, manufacturing, industrial, etc.)

6. **Description of Well:** Depth 30 feet. Type drilled (Dug or drilled)

diameter 10 inches. Elevation of ground at well site 210 (As near as known) feet, mean sea level.

Depth to water table 12 feet.

7. **Capacity of Well:** 350 g.p.m. with 5 feet drawdown.

_____ g.p.m. with _____ feet drawdown.

Date of test never tested

If Flowing Well: Measured discharge _____ g.p.m. on _____ (Date)

Shut-in pressure at ground surface _____ lbs. per sq. in. on _____ (Date)

Water is controlled by _____ (Cap, valve, etc.)

4M—4-57

8. **Casing:** (Give diameter, commercial specifications and depth below ground surface of each casing size.)

10 inch diameter steel casing from 0 to 30 feet

..... inch diameter ..... from ..... to ..... feet

..... inch diameter ..... from ..... to ..... feet

..... inch diameter ..... from ..... to ..... feet

Describe and show depth of shoe, plug, adapter, liner or other details: .....

9. **Perforated Casings or Screens:**

20 per foot 1/2 inch perforations from 25 to 30
(Number per foot and size of perforations, or describe screen)

..... from ..... to .....

..... from ..... to .....

..... from ..... to .....

10. **Log of Well:** (Describe each stratum or formation clearly, indicate if water bearing, and give thickness and depth as indicated.)

MATERIAL	Thickness (Feet)	Depth to Bottom (Feet)

GR - 1059 A

If log of well is not available, give name and address of driller. .....

Frank Skillings Corvallis, Oregon

11. **Infiltration Trench:** Covered or open .....

Dimensions: Length ..... ft. Minimum depth ..... ft. Maximum depth ..... ft.

Bottom width ..... ft. Discharge ..... g.p.m. Date of test .....

12. **Tunnel:** Type of lining .....

Dimensions: .....
(Length, course, and cross sectional size)

Position of water bearing stratum with reference to portal of tunnel .....

Log of tunnel: (Preceding table for log of well may be used, if desired. Give footage from portal and character of materials, as pertinent.)

13. **Pumping Equipment:**

(a) Pump two inch Fairbanks Morse (Make, type and size) Capacity 400 g.p.m.

(b) Motor 15 H.P. Fairbanks Morse (Type and horsepower)

14. Location of area irrigated or to be irrigated, or place of use if for purposes other than irrigation.

Township North or South	Range E. or W. of Willamette Meridian	Section	Forty-acre Tract	Number Acres To Be Irrigated	Date of Reclamation
11 S	4 W	31	NW 1/4 of NW 1/4	34.8	1950
11 S	4 W	31	SW 1/4 of NW 1/4	2	1950
11 S	4 W	30	SW 1/4 of SW 1/4	37	1950
11 S	5 W	25	SE 1/4 of SE 1/4	7	1950
11 S	5 W	36	NE 1/4 of NE 1/4	1	1950
				80.0 total	

15. If the ground water supply is supplemental to an existing water supply, identification of any application for a permit, permit, certificate or adjudicated right to appropriate water made or held by the registrant.

.....

.....

GR-1059 B

Township 11S Range 4 & 5W, W.M.

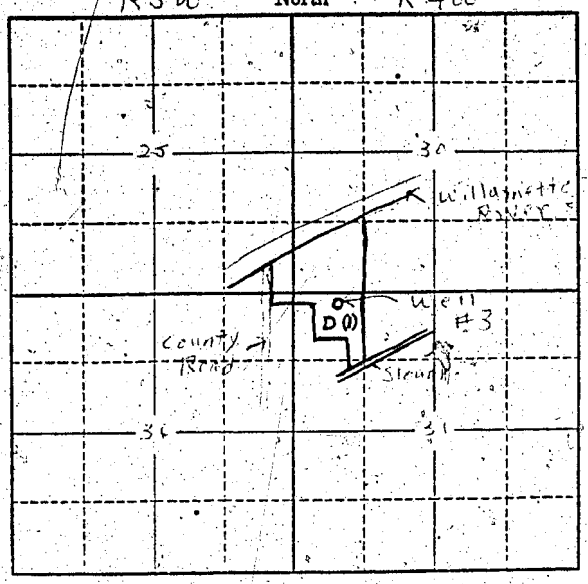

Locate well and acreage of irrigated land on plat.

Scale: 2" = 1 Mile

STATE OF OREGON
County of Benton } ss.

I, North Blacker, being first duly sworn, do hereby certify that I have read the foregoing Registration Statement and that all of the items therein contained are true to the best of my knowledge and belief.

North Blacker
(Signature of Registrant)

Subscribed and sworn to before me this 26th day of February, 1958

My commission expires Sept. 29, 1961

(Notary Public)

(SEAL)

CERTIFICATE OF REGISTRATION

STATE OF OREGON
County of Marion } ss.

This is to certify that the foregoing Registration Statement was received in the office of the State Engineer on the 27th day of February, 1958, at 9:15 o'clock A. M. and has been duly recorded in said office in Book No. 5 of Registration Statements on page GR-1059 C

Witness my hand this 30th day of June, 1958

Lewis A. Stanley
(State Engineer)

$22.50

By
(Deputy)

GR-1059 C