

Registration No. GR - 1099

Certificate No. GR - 1060

Registration Statement

OF CLAIMANT OF RIGHT TO APPROPRIATE GROUND WATER

TO THE STATE ENGINEER OF OREGON:

Well # 4

I, Allison & Blacker Farms
of Route 4, Box 314, Corvallis County of Linn
(Mailing address)

State of Oregon, do hereby make application for a certificate of registration as evidence of a right to appropriate ground water.

1. Source from which water is withdrawn is pump well #4
(Flowing well, pump well, infiltration trench, or tunnel)

2. Location is: two miles N.E. of Corvallis
(Approximate distance and direction from nearest city or town)

and is more particularly described as follows:

(a) 190 feet N 61° E to section corner 30 & 31 T 11 S R 4 W
(Give distance and bearing to corner of section or other legal subdivision)
being within SE 1/4 of SW 1/4 of Sec. 30, Twp. 11 S, Rge. 4
(Smallest legal subdivision) (N. or S.) (E. or W.)

or (b) within limits of recorded platted property, town or city:
in Lot _____, Block _____ of _____
(Name of plat or addition)

County of _____
(If within city or town, give name)

3. Construction Work was begun on April 1955; was completed on April 1955
(Date) (Date)

and the ground water claimed was first used for the purposes set out below on May 1955
(Date)

since which time the water has been used continuously every summer
(Continuously or intermittently)
from 1955 to 1956
(Date) (Date)

4. Quantity of water claimed and used is 500 gallons per minute; 30 acre feet per year.

5. Purpose or Purposes for which water is used irrigation
(Domestic, irrigation, municipal, manufacturing, industrial, etc.)

6. Description of Well: Depth 30 feet. Type drilled
(Dug or drilled)
diameter 10 inches. Elevation of ground at well site 240 feet, mean sea level.
(As near as known)

Depth to water table 8 feet.

7. Capacity of Well: 500 g.p.m. with 4 feet drawdown.
_____ g.p.m. with _____ feet drawdown.


Date of test never tested

If Flowing Well: Measured discharge _____ g.p.m. on _____
(Date)

Shut-in pressure at ground surface _____ lbs. per sq. in. on _____
(Date)

Water is controlled by _____
(Cap, valve, etc.)

Township 11 S Range 4 W W.M.
 S.W. North 4 W

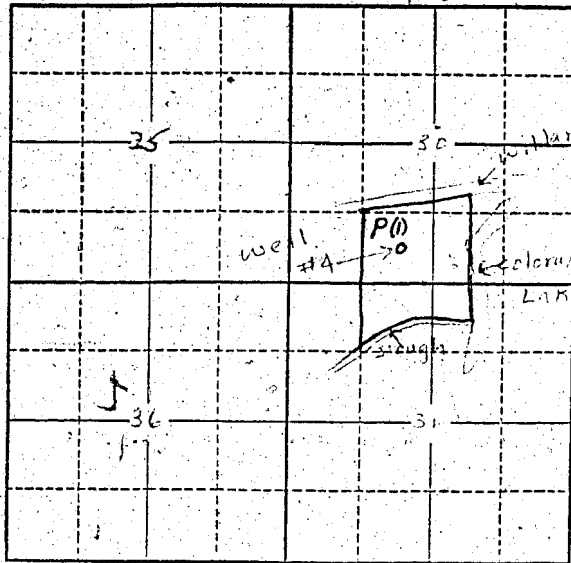

Locate well and acreage of irrigated land on plat.
 Scale: 2" = 1 Mile

STATE OF OREGON

County of Benton } ss.

I, Worth Blacker, being first duly sworn, do hereby certify that I have read the foregoing Registration Statement and that all of the items therein contained are true to the best of my knowledge and belief.

Worth Blacker
 (Signature of Registrant)

Subscribed and sworn to before me this 26th day of February, 19 58

My commission expires Sept. 29, 1961

Margaret B. Llanos
 (Notary Public)

(SEAL)

CERTIFICATE OF REGISTRATION

STATE OF OREGON

County of Marion } ss.

This is to certify that the foregoing Registration Statement was received in the office of the State Engineer on the 27th day of February, 19 58, at 9:15 o'clock A. M. and has been duly recorded in said office in Book No. 5 of Registration Statements on page GR-1060C

Witness my hand this 30th day of June, 19 58

Laura A. Stanley
 (State Engineer)

By _____ (Deputy)

GR-1060C