RECEIVED
[illegible]

Registration No. GR - 1100

Certificate No. GR - 1061

Registration Statement

OF CLAIMANT OF RIGHT TO APPROPRIATE GROUND WATER

TO THE STATE ENGINEER OF OREGON:

I, Memory Gardens by William S. Ferris, Manager,

of 1395 Arnold Lane, Medford, Oregon (Mailing address) County of Jackson

State of Oregon, do hereby make application for a certificate of registration as evidence of a right to appropriate ground water.

1. **Source** from which water is withdrawn is infiltration trench (Flowing well, pump well, infiltration trench, or tunnel)

2. **Location is:** 3½ miles southwest of Medford, Oregon (Approximate distance and direction from nearest city or town);

and is more particularly described as follows:

(a) 952 feet north and 744 feet east from the SW corner of DLC #78 (to pump) (Give distance and bearing to corner of section or other legal subdivision)

being within NE¼ (SW¼ NW¼) & NW¼ (SE¼ NW¼) (Smallest legal subdivision) of Sec. 34, Twp. 37 S. (N. or S.), Rge. 2 W. (E. or W.)

or (b) within limits of recorded platted property, town or city:

in Lot ....., Block ..... of ..... (Name of plat or addition)

..... (If within city or town, give name) County of .....

3. **Construction Work** was begun on September 1954 (Date); was completed on April 1955 (Date)

and the ground water claimed was first used for the purposes set out below on September, 1954 (Date),

since which time the water has been used continuously (Continuously or intermittently)

from Sept. 1954 (Date) to Date (Date)

4. **Quantity** of water claimed and used is 300 gallons per minute; 160 acre feet per year.

5. **Purpose or Purposes** for which water is used irrigation

..... (Domestic, irrigation, municipal, manufacturing, industrial, etc.)

See Item 16 6. **Description of Well:** Depth 14 feet. Type dug (Dug or drilled)

diameter 70'x200' inches. Elevation of ground at well site 1460 (As near as known) feet, mean sea level.

Depth to water table 1.0 feet.

7. **Capacity of Well:** ..... g.p.m. with ..... feet drawdown.

..... g.p.m. with ..... feet drawdown.

Date of test none

If Flowing Well: Measured discharge ..... g.p.m. on ..... (Date)

Shut-in pressure at ground surface ..... lbs. per sq. in. on ..... (Date)

Water is controlled by ..... (Cap, valve, etc.)

4M—4-57

8. **Casing:** (Give diameter, commercial specifications and depth below ground surface of each casing size.)

..... inch diameter ....none.... from ..... to ..... feet

..... inch diameter ..... from ..... to ..... feet

..... inch diameter ..... from ..... to ..... feet

..... inch diameter ..... from ..... to ..... feet

Describe and show depth of shoe, plug, adapter, liner or other details: .....

.....

.....

9. **Perforated Casings or Screens:**

....none.... from ..... to .....
(Number per foot and size of perforations, or describe screen)

..... from ..... to .....

..... from ..... to .....

..... from ..... to .....

10. **Log of Well:** (Describe each stratum or formation clearly, indicate if water bearing, and give thickness and depth as indicated.)

MATERIAL	Thickness (Feet)	Depth to Bottom (Feet)
clay loam (Water bearing)	9	5
cement gravel	5	0

GR – 1061 A

If log of well is not available, give name and address of driller. .....

11. **Infiltration Trench:** Covered or open open

Dimensions: Length 200 ft. Minimum depth 12 ft. Maximum depth 14 ft.

Bottom width 70 ft. Discharge ..... g.p.m. Date of test none

12. **Tunnel:** Type of lining .....

Dimensions: .....
(Length, course, and cross sectional size)

Position of water bearing stratum with reference to portal of tunnel .....

Log of tunnel: (Preceding table for log of well may be used, if desired. Give footage from portal and character of materials, as pertinent.)

13. **Pumping Equipment:**

(a) Pump 2.5 inch centrifugal (Make, type and size) Capacity 300 g.p.m.

(b) Motor 15 H.P. electric motor (Type and horsepower)

14. Location of area irrigated or to be irrigated, or place of use if for purposes other than irrigation.

Township North or South	Range E. or W. of Willamette Meridian	Section	Forty-acre Tract	Number Acres To Be Irrigated	Date of Reclamation
37 S.	2 W.	34	SW¼ NW¼	23.0	Sept. 1954
"	"	"	SE¼ NW¼	13.6	Sept. 1954
"	"	"	NW¼ SW¼	[illegible].2	Sept. 1954
"	"	"	NE¼ SW¼	1.2	Sept. 1954
"	"			40.0 acres	

15. If the ground water supply is supplemental to an existing water supply, identification of any application for a permit, permit, certificate or adjudicated right to appropriate water made or held by the registrant.

none

GR-1061 B

Township 37 S. Range 2 W., W.M.

North

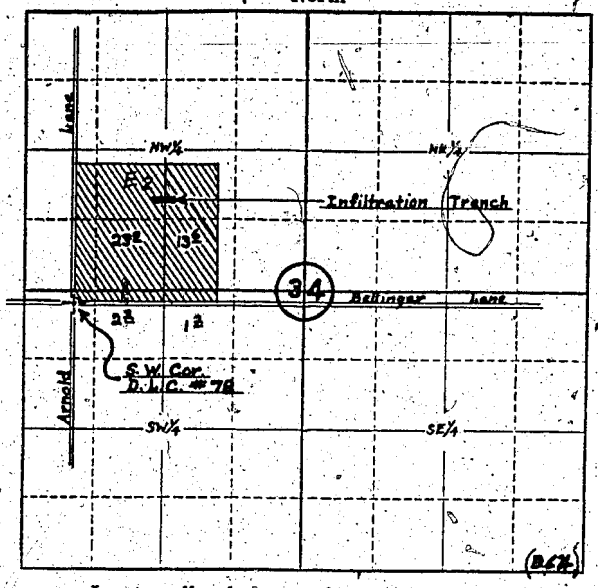

Locate well and acreage of irrigated land on plat.

Scale: 4" = 1 Mile

STATE OF OREGON
County of Jackson } ss.

I, Wm. S. Ferris, being first duly sworn, do hereby certify that I have read the foregoing Registration Statement and that all of the items therein contained are true to the best of my knowledge and belief.

(Signature of Registrant)

Subscribed and sworn to before me this 26th day of February, 19 58

My commission expires August 25, 1958

(Notary Public)

(SEAL)

CERTIFICATE OF REGISTRATION

STATE OF OREGON
County of Marion } ss.

This is to certify that the foregoing Registration Statement was received in the office of the State Engineer on the 27th day of February, 19 58, at 2 o'clock P.M. and has been duly recorded in said office in Book No. 5 of Registration Statements on page GR-1061C.

Witness my hand this 30th day of June, 19 58

Lewis A. Stanley
(State Engineer)

By
(Deputy)

GR - 1061 C