RECEIVED
STATE ENGINEER

REGISTRATION NO. GR-1101
CERTIFICATE NO. GR-1062

Registration Statement

OF CLAIMANT OF RIGHT TO APPROPRIATE GROUND WATER

(Under Chapter 708, Oregon Laws 1955.)

TO THE STATE ENGINEER OF OREGON:

I, RODERICK M. LIVESLEY,

of Salem County of Marion

State of Oregon, do hereby make application for a certificate of registration as evidence of a right to appropriate ground water.

1. **Source** from which water is withdrawn is pump well (Flowing well, pump well, infiltration trench, or tunnel)

2. **Location is:** 6 miles South East of Salem (Approximate distance and direction from nearest city or town);

and is more particularly described as follows:

(a) South East corner is 1½ chains North & 21 chains East of South West Corner Sec. 34 (1200 feet west & 1000 feet north from SE corner Section 33) (Give distance and bearing to corner of section or other legal subdivision)

being within South½ of South½ (Smallest legal subdivision) of Sec. 33 ~~& 34~~, Twp. 7 S (N. or S.), Rge. 2W (E. or W.)

or (b) within limits of recorded platted property, town or city:

in Lot ....., Block ..... of ..... (Name of plat or addition)

..... (If within city or town, give name) County of .....

3. **Construction Work** was begun on Aug. 11, 1950 (Date); was completed on Aug. 22, 1950 (approx) (Date)

and the ground water claimed was first used for the purposes set out below on Sept. 1950 (Date)

since which time the water has been used intermittently (Continuously or intermittently)

from Sept. 1950 (Date) to Aug. 1957 (Date)

4. **Quantity** of water claimed and used is 85 gallons per minute; ..... acre feet per year.

5. **Purpose or Purposes** for which water is used irrigation

..... (Domestic, irrigation, municipal, manufacturing, industrial, etc.)

6. **Description of Well:** Depth 130 feet. Type drilled (Dug or drilled)

diameter 10 inches. Elevation of ground at well site 285 (As near as known) feet, mean sea level.

Depth to water table 32 feet.

7. **Capacity of Well:** 85 g.p.m. with 75 feet drawdown.

..... g.p.m. with ..... feet drawdown.

Date of test Aug. 1950

If Flowing Well: Measured discharge ..... g.p.m. on ..... (Date)

Shut-in pressure at ground surface ..... lbs. per sq. in. on ..... (Date)

Water is controlled by ..... (Cap, valve, etc.)

8. **Casing:** (Give diameter, commercial specifications and depth below ground surface of each casing size.)

10" inch diameter steel from 0 to 130 feet

inch diameter from to feet

inch diameter from to feet

inch diameter from to feet

Describe and show depth of shoe, plug, adapter, liner or other details:

9. **Perforated Casings or Screens:**

not known (Number per foot and size of perforations, or describe screen) from to

from to

from to

from to

10. **Log of Well:** (Describe each stratum or formation clearly, indicate if water bearing, and give thickness and depth as indicated.)

MATERIAL	Thickness (Feet)	Depth to Bottom (Feet)
unk		

GR-1062 A

If log of well is not available, give name and address of driller. Studebaker Bros.

address unknown

11. **Infiltration Trench:** Covered or open .....

Dimensions: Length ..... ft. Minimum depth ..... ft. Maximum depth ..... ft.

Bottom width ..... ft. Discharge ..... g.p.m. Date of test .....

12. **Tunnel:** Type of lining .....

Dimensions: .....
(Length, course, and cross sectional size)

Position of water bearing stratum with reference to portal of tunnel .....

Log of tunnel: (Preceding table for log of well may be used, if desired. Give footage from portal and character of materials, as pertinent.)

13. **Pumping Equipment:** To be replaced

(a) Pump none (sold Jan. 1957) Capacity ..... g.p.m.
(Make, type and size)

(b) Motor .....
(Type and horsepower)

14. Location of area irrigated or to be irrigated, or place of use if for purposes other than irrigation.

Township North or South	Range E. or W. of Willamette Meridian	Section	Forty-acre Tract	Number Acres To Be Irrigated	Date of Reclamation
T 7 S	R 2 W	33	SE $\frac{1}{4}$ of SE$\frac{1}{4}$	35	Sept. 1950

15. If the ground water supply is supplemental to an existing water supply, identification of any application for a permit, permit, certificate or adjudicated right to appropriate water made or held by the registrant.

.....

GR-1062 B

Township 7 S Range 2 W, W.M.

North

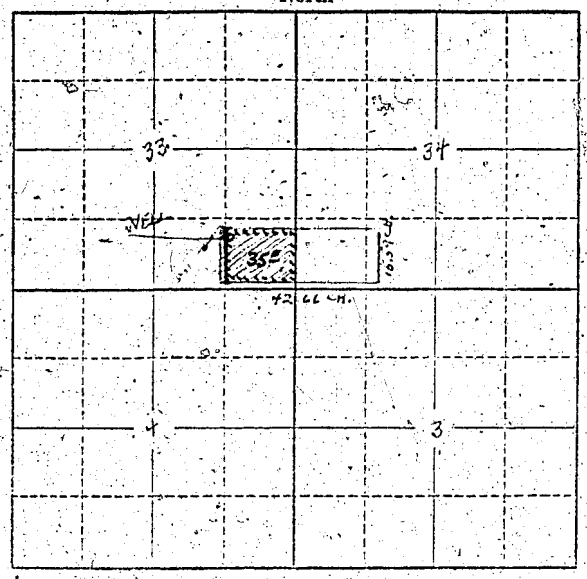

SHADED PORTION TO BE IRRIGATED

Locate well and acreage of irrigated land on plat.

~~Scale: 2" = 1 Mile~~

STATE OF OREGON
County of MARION } ss.

I, Roderick M. Livesley, being first duly sworn, do hereby certify that I have read the foregoing Registration Statement and that all of the items therein contained are true to the best of my knowledge and belief.

(Signature of Registrant)

Subscribed and sworn to before me this 26th day of February, 19[illegible]

My commission expires 5-[illegible]-58 (Notary Public)

(SEAL)

CERTIFICATE OF REGISTRATION

STATE OF OREGON
County of Marion } ss.

This is to certify that the foregoing Registration Statement was received in the office of the State Engineer on the 27th day of February, 19[illegible], at [illegible] o'clock [illegible] M. and has been duly recorded in said office in Book No. 5 of Registration Statements on page GR-1062C

~~[illegible]~~

Witness my hand this 30th day of June, 19 58

Peter A. Stanley (State Engineer)

By (Deputy)

GR-1062 C