

Registration No. GR - 1105

Certificate No. GR - 1065

Registration Statement

OF CLAIMANT OF RIGHT TO APPROPRIATE GROUND WATER

TO THE STATE ENGINEER OF OREGON:

I, Edgar and Viola McMorris
of Rt. 3, Box 791, Albany County of Linn
(Mailing address)
State of Oregon, do hereby make application for a certificate of registration as evidence of a right to appropriate ground water.

1. Source from which water is withdrawn is pump well
(Flowing well, pump well, infiltration trench, or tunnel)
2. Location is: 3 miles east of Corvallis, Oregon
(Approximate distance and direction from nearest city or town)

and is more particularly described as follows:

(a) 165 feet north and 2838 feet west of SE corner S. 32, T. 11 S. R. 4 W.
(Give distance and bearing to corner of section or other legal subdivision)
being within SE 1/4 of SW 1/4 of Sec. 32, Twp. 11 S, Rge. 4 W
(Smallest legal subdivision) (N. or S.) (E. or W.)

or (b) within limits of recorded platted property, town or city:
in Lot _____, Block _____ of _____
(Name of plat or addition)
County of Linn
(If within city or town, give name)

3. Construction Work was begun on Aug. 1946; was completed on August 1946
(Date) (Date)
and the ground water claimed was first used for the purposes set out below on October 1946
(Date)
since which time the water has been used continuously
(Continuously or intermittently)
from Oct. 1946 to present time
(Date) (Date)

4. Quantity of water claimed and used is 50 gallons per minute; 20 acre feet per year.


5. Purpose or Purposes for which water is used Irrigation
(Domestic, irrigation, municipal, manufacturing, industrial, etc.)

6. Description of Well: Depth 22 feet. Type Dug
(Dug or drilled)
diameter 12 inches. Elevation of ground at well site 225 feet, mean sea level.
(As near as known)
Depth to water table 3 feet.

7. Capacity of Well: 50 g.p.m. with 12 feet drawdown.
_____ g.p.m. with _____ feet drawdown.
Date of test Aug. 1957

If Flowing Well: Measured discharge _____ g.p.m. on _____
(Date)
Shut-in pressure at ground surface _____ lbs. per sq. in. on _____
(Date)
Water is controlled by _____
(Cop. valve, etc.)

Township 11 S Range 4 W, W.M.
North

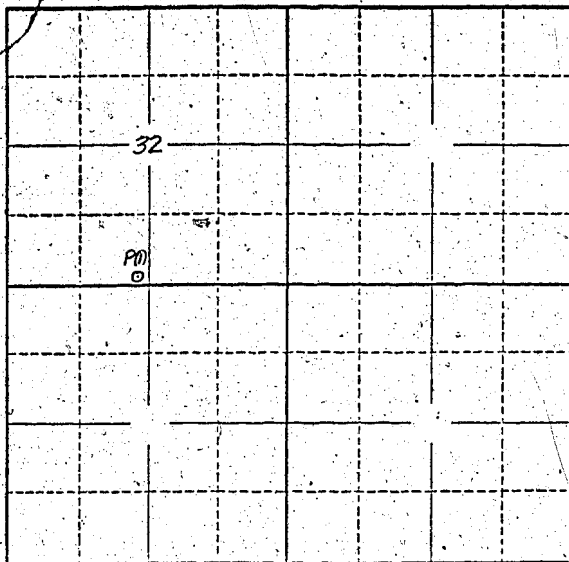

Locate well and acreage of irrigated land on plat.
Scale: 2" = 1 Mile

STATE OF OREGON
County of Benton } ss.

I, Edgar and Viola McMorris, being first duly sworn, do hereby certify that I have read the foregoing Registration Statement and that all of the items therein contained are true to the best of my knowledge and belief.

Edgar & Viola McMorris
Viola McMorris
(Signature of Registrant)

Subscribed and sworn to before me this 25 day of February, 1958

My commission expires 2001

Ann S. Haver
(Notary Public)

(SEAL)

CERTIFICATE OF REGISTRATION

STATE OF OREGON } ss.
County of Marion

This is to certify that the foregoing Registration Statement was received in the office of the State Engineer on the 25th day of February, 1958, at 6:00 o'clock P.M. and has been duly recorded in said office in Book No. 5 of Registration Statements on page GR-1065 C

Witness my hand this 30th day of June, 1958

\$15.00

Laura A. Stanley
(State Engineer)

By _____ (Deputy)

GR-1065.C