REGISTRATION NO. GR-1108

CERTIFICATE NO. GR-1068

Registration Statement

OF CLAIMANT OF RIGHT TO APPROPRIATE GROUND WATER

(Under Chapter 708, Oregon Laws 1955.)

TO THE STATE ENGINEER OF OREGON:

I, Lex C Rea RT-1 Box-163 Turner,

of North Santiam County of Marion

State of Oregon, do hereby make application for a certificate of registration as evidence of a right to appropriate ground water.

1. **Source** from which water is withdrawn is Infiltration Trench (Flowing well, pump well, infiltration trench, or tunnel)

2. **Location** is: 6 Miles west of Stayton (Approximate distance and direction from nearest city or town);

and is more particularly described as follows:

(a) 1860 feet north & 300 feet east from S 1/4 corner Section 23 (Give distance and bearing to corner of section or other legal subdivision)

being within NW 1/4 of SE 1/4 (Smallest legal subdivision) of Sec. 23, Twp. 9 South (N. or S.), Rge. 2 West (E. or W.)

or (b) within limits of recorded platted property, town or city:

in Lot ....., Block ....., of ..... (Name of plat or addition)

..... (If within city or town, give name) County of .....

3. **Construction Work** was begun on May 1949 (Date); was completed on May 1949 (Date)

and the ground water claimed was first used for the purposes set out below on May 1949 (Date)

since which time the water has been used Continuously (Continuously or intermittently)

from May 1949 (Date) to Oct. 1957 (Date)

4. **Quantity** of water claimed and used is 200 gallons per minute; ..... acre feet per year.

5. **Purpose or Purposes** for which water is used Irrigation

..... (Domestic, irrigation, municipal, manufacturing, industrial, etc.)

6. **Description of Well:** Depth — feet. Type Sump (Dug or drilled)

diameter — inches. Elevation of ground at well site 340 (As near as known) feet, mean sea level.

Depth to water table 6 feet. Summer

7. **Capacity of Well:** None g.p.m. with ..... feet drawdown.

..... g.p.m. with ..... feet drawdown.

Date of test —

If Flowing Well: Measured discharge ..... g.p.m. on ..... (Date)

Shut-in pressure at ground surface ..... lbs. per sq. in. on ..... (Date)

Water is controlled by ..... (Cap, valve, etc.)

8. **Casing:** (Give diameter, commercial specifications and depth below ground surface of each casing size.)

..... inch diameter ....not appl.... from ..... to ..... feet

..... inch diameter ..... from ..... to ..... feet

..... inch diameter ..... from ..... to ..... feet

..... inch diameter ..... from ..... to ..... feet

Describe and show depth of shoe, plug, adapter, liner or other details: .....

.....

.....

9. **Perforated Casings or Screens:**

....not appl.... from ..... to .....
(Number per foot and size of perforations, or describe screen)

..... from ..... to .....

..... from ..... to .....

..... from ..... to .....

10. **Log of Well:** (Describe each stratum or formation clearly, indicate if water bearing, and give thickness and depth as indicated.)

MATERIAL	Thickness (Feet)	Depth to Bottom (Feet)
not appl		

GR-1068 A

If log of well is not available, give name and address of driller. .....

11. **Infiltration Trench:** Covered or open Open

Dimensions: Length 381 ft. Minimum depth 9' ft. Maximum depth 16' ft.

Bottom width 10' ft. Discharge 200 g.p.m. Date of test May 1949

12. **Tunnel:** Type of lining .....

Dimensions: .....
(Length, course, and cross sectional size)

Position of water bearing stratum with reference to portal of tunnel .....

Log of tunnel: (Preceding table for log of well may be used, if desired. Give footage from portal and character of materials, as pertinent.)

13. **Pumping Equipment:**

(a) Pump Pacific Centrifugal 2" (Make, type and size) Capacity 200 g.p.m.

(b) Motor 10 H.P. Electric (Type and horsepower)

14. Location of area irrigated or to be irrigated, or place of use if for purposes other than irrigation.

Township North or South	Range E or W. of Willamette Meridian	Section	Forty-acre Tract	Number Acres To Be Irrigated	Date of Reclamation
9 South	2 West	23	NW1/4 of SE1/4	12 acres	May 1949

15. If the ground water supply is supplemental to an existing water supply, identification of any application for a permit, permit, certificate or adjudicated right to appropriate water made or held by the registrant.

.....

GR-1068 B

Township 9S Range 2W, W.M.

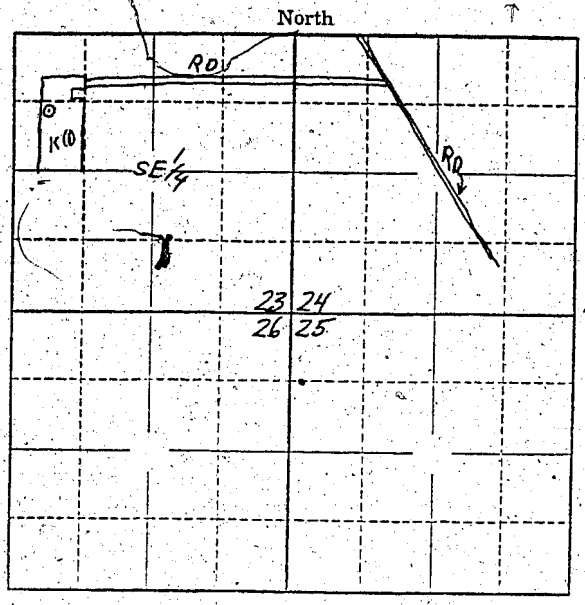

Locate well and acreage of irrigated land on plat.

Scale: 4" = 1 Mile

STATE OF OREGON
County of Marion } ss.

I, ..., being first duly sworn, do hereby certify that I have read the foregoing Registration Statement and that all of the items therein contained are true to the best of my knowledge and belief.

Lee C Rea
(Signature of Registrant)

Subscribed and sworn to before me this 28th day of February, 19 58

My commission expires 12th June 1961 Wm. S. Bartholomew
(Notary Public)

(SEAL)

CERTIFICATE OF REGISTRATION

STATE OF OREGON
County of Marion } ss.

This is to certify that the foregoing Registration Statement was received in the office of the State Engineer on the 28th day of February, 1958, at 2:30 o'clock P. M. and has been duly recorded in said office in Book No. 5 of Registration Statements on page GR-1068C

[redacted]

Witness my hand this 30th day of June, 19 58.

Lewis A. Stanley
(State Engineer)

By .....
(Deputy)

GR-1068 C