RECEIVED
MAR 3 1958
STATE ENGINEER
SALEM, OREGON

REGISTRATION NO. GR-1109
CERTIFICATE NO. GR-1069

Registration Statement

OF CLAIMANT OF RIGHT TO APPROPRIATE GROUND WATER

(Under Chapter 708, Oregon Laws 1955.)

TO THE STATE ENGINEER OF OREGON:

I, VIRGIL J. RYAN

of R-2, Woodburn County of Marion

State of Ore., do hereby make application for a certificate of registration as evidence of a right to appropriate ground water.

1. **Source** from which water is withdrawn is pumpwell (Flowing well, pump well, infiltration trench, or tunnel)

2. **Location is:** 1½ mi. W of Monitor, Ore.; (Approximate distance and direction from nearest city or town)

and is more particularly described as follows:

(a) 334' N and 690' E. of the center Sec 26 V. J. Ryan (Give distance and bearing to corner of section or other legal subdivision)

being within SW ¼ NE ¼ (Smallest legal subdivision) of Sec. 26, Twp. 5S (N. or S.), Rge. 1W (E. or W.)

or (b) within limits of recorded platted property, town or city:

in Lot ....., Block ..... of ..... (Name of plat or addition)

..... County of ..... (If within city or town, give name)

3. **Construction Work** was begun on April 1, 1951 (Date); was completed on April 18, 1951 (Date)

and the ground water claimed was first used for the purposes set out below on May 1, 1952 (Date)

since which time the water has been used intermittently (Continuously or intermittently)

from May 1, 1952 (Date) to Oct. 1, 1957 (Date)

4. **Quantity** of water claimed and used is 85 gallons per minute; ..... acre feet per year.

5. **Purpose or Purposes** for which water is used ~~supplemental~~ irrigation (Domestic, irrigation, municipal, manufacturing, industrial, etc.)

6. **Description of Well:** Depth 114 feet. Type Dug (Dug or drilled)

diameter 6 inches. Elevation of ground at well site 195 (As near as known) feet, mean sea level.

Depth to water table 45 feet.

7. **Capacity of Well:** 180 g.p.m. with 22 feet drawdown.

..... g.p.m. with ..... feet drawdown.

Date of test April 19, 1951

If Flowing Well: Measured discharge ..... g.p.m. on ..... (Date)

Shut-in pressure at ground surface ..... lbs. per sq. in. on ..... (Date)

Water is controlled by ..... (Cap, valve, etc.)

8. **Casing:** (Give diameter, commercial specifications and depth below ground surface of each casing size.)

6 inch diameter from 0 to 114 feet

inch diameter from to feet

inch diameter from to feet

inch diameter from to feet

Describe and show depth of shoe, plug, adapter, liner or other details: None

9. **Perforated Casings or Screens:**

1 rows 9 mills per. from 70 to 85
(Number per foot and size of perforations, or describe screen)

2 " 9 " " from 85 to 110

from to

from to

10. **Log of Well:** (Describe each stratum or formation clearly, indicate if water bearing, and give thickness and depth as indicated.)

MATERIAL	Thickness (Feet)	Depth to Bottom (Feet)
Brown gravel	5	75
Blue gravel	25	110

GR-1069 A

If log of well is not available, give name and address of driller. .....

.....

11. **Infiltration Trench:** Covered or open .....

Dimensions: Length ..... ft. Minimum depth ..... ft. Maximum depth ..... ft.

Bottom width ..... ft. Discharge ..... g.p.m. Date of test .....

12. **Tunnel:** Type of lining .....

Dimensions: .....
(Length, course, and cross sectional size)

Position of water bearing stratum with reference to portal of tunnel .....

.....

Log of tunnel: (Preceding table for log of well may be used, if desired. Give footage from portal and character of materials, as pertinent.)

13. **Pumping Equipment:**

(a) Pump Peerless Lineshaft Turbine ..... Capacity 85 g.p.m.
(Make, type and size)

(b) Motor Westinghouse Vert. Hollow shaft 5 HP electric
(Type and horsepower)

14. Location of area irrigated or to be irrigated, or place of use if for purposes other than irrigation.

Township North or South	Range E. or W. of Willamette Meridian	Section	Forty-acre Tract	Number Acres To Be Irrigated	Date of Reclamation
5S	1W	26	SW¼ + NE¼	10	1952
5S	1W	26	SW¼ NE¼	10 Total	1952

15. If the ground water supply is supplemental to an existing water supply, identification of any application for a permit, permit, certificate or adjudicated right to appropriate water made or held by the registrant.

None

.....

GR-1069 B

Township 5S Range 1W, W.M.

North

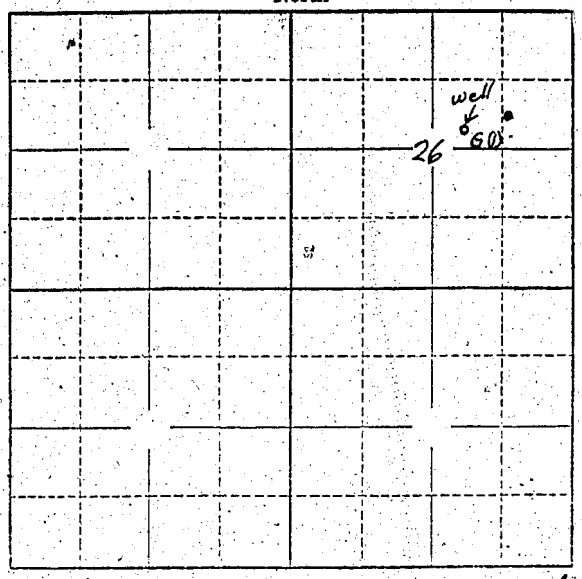

Locate well and acreage of irrigated land on plat.

Scale: 2" = 1 Mile

STATE OF OREGON
County of Marion } ss.

I, Virgil J. Ryan, being first duly sworn, do hereby certify that I have read the foregoing Registration Statement and that all of the items therein contained are true to the best of my knowledge and belief.

Virgil J. Ryan
(Signature of Registrant)

Subscribed and sworn to before me this 20th day of February, 1958.

My commission expires Sept. 8, 1960

(Notary Public)

(SEAL)

CERTIFICATE OF REGISTRATION

STATE OF OREGON
County of Marion } ss.

This is to certify that the foregoing Registration Statement was received in the office of the State Engineer on the ..... day of ....., 19..., at ..... o'clock ..... M. and has been duly recorded in said office in Book No. 5 of Registration Statements on page GR-1069 C

[redacted]

Witness my hand this 30th day of June, 1958

Lewis A. Stanley
(State Engineer)

By .....
(Deputy)

GR-1069 C