

RECEIVED
MAR 3 1958
STATE ENGINEER
SALEM, OREGON

Registration No. GR - 1110
Certificate No. GR 1070

Registration Statement

OF CLAIMANT OF RIGHT TO APPROPRIATE GROUND WATER

TO THE STATE ENGINEER OF OREGON:

I, John I. Haas, Inc., of Baltimore, Maryland - Mitoma Farm,
of Route 1, Box 3, Independence County of Folk
(Mailing address)
State of Oregon, do hereby make application for a certificate of registration as evidence
of a right to appropriate ground water.

1. Source from which water is withdrawn is pump well
(Flowing well, pump well, infiltration trench, or tunnel)

2. Location is: 5 Mi. northeast of Independence, Oregon
(Approximate distance and direction from nearest city or town)

and is more particularly described as follows: 2100 feet North & 2000 feet west from SE corner Sect. 11

(a) NE 1210 ft. from S.W. corner of SE
(Give distance and bearing to corner of section or other legal subdivision)

being within NW 1/4 of SE 1/4 of Sec. 11, Twp. B. 3, Rge. 4
(Smallest legal subdivision) (N. or S.) (E. or W.)

or (b) within limits of recorded platted property, town or city:

in Lot _____, Block _____ of _____
(Name of plat or addition)

County of _____
(If within city or town, give name)

3. Construction Work was begun on June 1950; was completed on June 1950
(Date) (Date)

and the ground water claimed was first used for the purposes set out below on June 1950
(Date)

since which time the water has been used intermittently
(Continuously or intermittently)

from June 1950 to October 1957
(Date) (Date)

4. Quantity of water claimed and used is 900 gallons per minute; one acre
feet per year.

5. Purpose or Purposes for which water is used irrigation

(Domestic, irrigation, municipal, manufacturing, industrial, etc.)

6. Description of Well: Depth 42 feet. Type drilled
(Dug or drilled)

diameter 12 inches. Elevation of ground at well site 150 feet, mean sea level.
(As near as known)

Depth to water table 19 feet.

7. Capacity of Well: 900 g.p.m. with 6 feet drawdown.

_____ g.p.m. with _____ feet drawdown.


Date of test June 1950

If Flowing Well: Measured discharge _____ g.p.m. on _____
(Date)

Shut-in pressure at ground surface _____ lbs. per sq. in. on _____
(Date)

Water is controlled by _____
(Cap. valve, etc.)

Township 8-S Range 4 W, W.M.
North

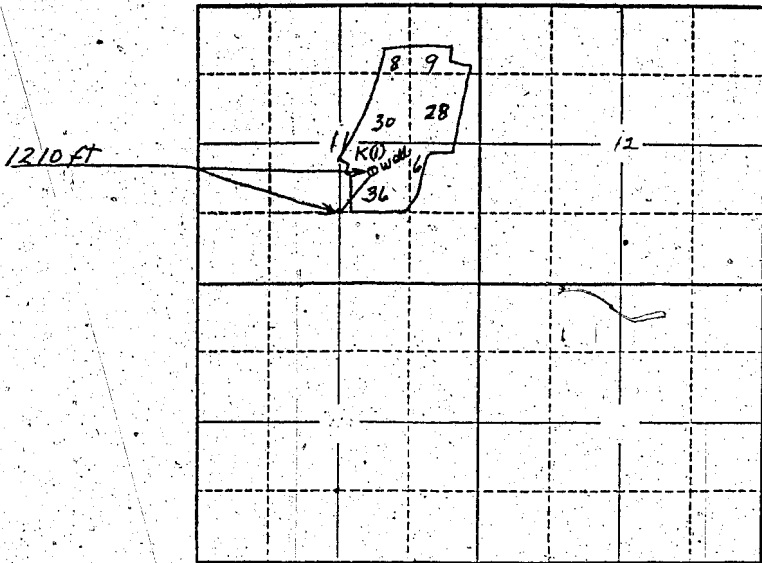

Locate well and acreage of irrigated land on plat.
Scale: 2" = 1 Mile

STATE OF OREGON

County of Folk

} ss.

I, Ralph Tantfest, being first duly sworn, do hereby certify that I have read the foregoing Registration Statement and that all of the items therein contained are true to the best of my knowledge and belief.

Ralph Tantfest
(Signature of Registrant)

Subscribed and sworn to before me this 27 day of February, 1957.

My commission expires Dec 12 1960

A.B. [Signature]
(Notary Public)

(SEAL)

CERTIFICATE OF REGISTRATION

STATE OF OREGON

County of Marion

} ss.

This is to certify that the foregoing Registration Statement was received in the office of the State Engineer on the 30th day of March, 1958, at 11:30 o'clock A. M. and has been duly recorded in said office in Book No. 5 of Registration Statements on page GR-1070C

Witness my hand this 30th day of June, 1958

Lewis A. Stanley
(State Engineer)

By

(Deputy)

GR - 1070 C