

RECEIVED
MAR 5 1958
STATE ENGINEER
SALEM, OREGON

Registration No. GR-1113
Certificate No. GR-1073

Registration Statement

OF CLAIMANT OF RIGHT TO APPROPRIATE GROUND WATER

TO THE STATE ENGINEER OF OREGON:

I, William J. Managro
of Rt. 1, Box 296, Gervais County of Marion
(Mailing address)
State of Oregon, do hereby make application for a certificate of registration as evidence of a right to appropriate ground water.

1. Source from which water is withdrawn is Pump Well #1
(Flowing well, pump well, infiltration trench, or tunnel)
2. Location is: 3 miles S.E. of St. Paul
(Approximate distance and direction from nearest city or town)

and is more particularly described as follows:

- (a) 600 feet east and 2500 feet South from N.W. corner Section 5, 5S - 2W
(Give distance and bearing to corner of section or other legal subdivision)
being within SW $\frac{1}{4}$ of NW $\frac{1}{4}$ of Sec. 05, Twp. 5 S, Rge. 2 W
(Smallest legal subdivision) (N. or S.) (E. or W.)
- or (b) within limits of recorded platted property, town or city:
in Lot _____, Block _____ of _____
(Name of plat or addition)

County of _____
(If within city or town, give name)

3. Construction Work was begun on March 1951; was completed on April 21, 1951
(Date) (Date)
and the ground water claimed was first used for the purposes set out below on May 15, 1951
(Date)
since which time the water has been used intermittently
(Continuously or intermittently)
from May to October of each year
(Date) (Date)

4. Quantity of water claimed and used is 300 gallons per minute; _____ acre feet per year.

5. Purpose or Purposes for which water is used irrigation
(Domestic, irrigation, municipal, manufacturing, industrial, etc.)

6. Description of Well: Depth 99 feet. Type drilled
(Dug or drilled)
diameter 12 inches. Elevation of ground at well site: 160 feet, mean sea level.
(As near as known)
Depth to water table 15 feet.

7. Capacity of Well: 400 g.p.m. with 20 feet drawdown.
_____ g.p.m. with _____ feet drawdown.
Date of test April 21, 1951

If Flowing Well: Measured discharge _____ g.p.m. on _____
(Date)
Shut-in pressure at ground surface _____ lbs. per sq. in. on _____
(Date)
Water is controlled by _____
(Cag, valve, etc.)

8. Casing: (Give diameter, commercial specifications and depth below ground surface of each casing size.)

12 inch diameter steel casing from 0 to 92 feet
inch diameter from to feet
inch diameter from to feet
inch diameter from to feet

Describe and show depth of shoe, plug, adapter, liner or other details:

9. Perforated Casings or Screens:

none from to
(Number per foot and size of perforations, or describe screen)
from to
from to
from to

10. Log of Well: (Describe each stratum or formation clearly, indicate if water bearing, and give thickness and depth as indicated.)

MATERIAL	Thickness (Feet)	Depth to Bottom (Feet)
sand - 70 to 80 feet. Pumped 700 gal. Would not hold.		
Packed with 20 yards of gravel.		
sand - 92 feet 6 inches to 99 feet. Well pumped		
820 gals. Cleared up at 400 gals.		

If log of well is not available, give name and address of driller.....

11. Infiltration Trench: Covered or open.....

Dimensions: Length ft. Minimum depth ft. Maximum depth ft.

Bottom width ft. Discharge g.p.m. Date of test

12. Tunnel: Type of lining.....

Dimensions:
(Length, course, and cross sectional size)

Position of water bearing stratum with reference to portal of tunnel

Log of tunnel: (Preceding table for log of well may be used, if desired. Give footage from portal and character of materials, as pertinent.)

13. Pumping Equipment:

(a) Pump Fairbanks - Morse turbine Capacity g.p.m.
(Make, type and size)


(b) Motor Electric - 3 phase - 20 H.P.
(Type and horsepower)

14. Location of area irrigated or to be irrigated, or place of use if for purposes other than irrigation.

Township North or South	Range E. or W. of Willamette Meridian	Section	Forty-acre Tract	Number Acres To Be Irrigated	Date of Reclamation
5 S	2 W	5	SE $\frac{1}{4}$ of NW $\frac{1}{4}$	5	May 1951
"	"	"	SW $\frac{1}{4}$ of NW $\frac{1}{4}$	7	"
"	"	"	NE $\frac{1}{4}$ of SW $\frac{1}{4}$	8	"
"	"	"	NW $\frac{1}{4}$ of SW $\frac{1}{4}$	15	"
"	"	6	SE $\frac{1}{4}$ of NE $\frac{1}{4}$	14	"
"	"	"	SW $\frac{1}{4}$ of NE $\frac{1}{4}$	7	"
"	"	"	NE $\frac{1}{4}$ of SE $\frac{1}{4}$	15	"
"	"	"	NW $\frac{1}{4}$ of SE $\frac{1}{4}$	8	"
				<u>79</u>	

15. If the ground water supply is supplemental to an existing water supply, identification of any application for a permit, permit, certificate or adjudicated right to appropriate water made or held by the registrant.

Township 5 S Range 2 W W.M.
North

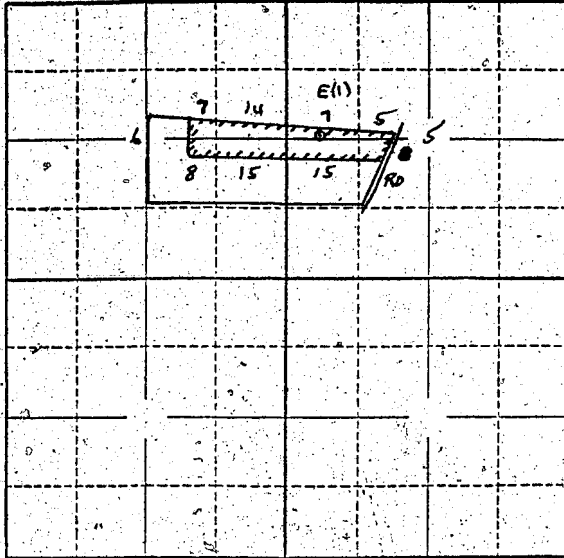

Locate well and acreage of irrigated land on plat.
Scale: 2" = 1 Mile

STATE OF OREGON

County of MARION } ss.

I, WILLIAM J. MANEGRE being first duly sworn, do hereby certify that I have read the foregoing Registration Statement and that all of the items therein contained are true to the best of my knowledge and belief.

William J. Manegre
(Signature of Registrant)

Subscribed and sworn to before me this 20th day of February, 1958

My commission expires 3-17-59

Edward J. Swartz
(Notary Public)

(SEAL)

CERTIFICATE OF REGISTRATION

STATE OF OREGON

County of Marion } ss.

This is to certify that the foregoing Registration Statement was received in the office of the State Engineer on the 5th day of March, 1956, at 2:00 o'clock P. M. and has been duly recorded in said office in Book No. 6 of Registration Statements on page GR-1073.

Witness my hand this 30th day of June, 1958

Laura A. Stanley
(State Engineer)

By _____ (Deputy)

GR 1073

\$22.35