

Registration No. GR - 1114

Certificate No. GR - 1074

Registration Statement

OF CLAIMANT OF RIGHT TO APPROPRIATE GROUND WATER

TO THE STATE ENGINEER OF OREGON:

I, Albert H. Pack

of R. 2. box 49 Salem County of Marion
(Mailing address) State of Oregon

do hereby make application for a certificate of registration as evidence of a right to appropriate ground water.

1. Source from which water is withdrawn is Pump Well #1
(Flowing well, pump well, infiltration trench, or tunnel)

2. Location is: 7 Miles N W Of Salem Ore
(Approximate distance and direction from nearest city or town)

and is more particularly described as follows:

(a) 2000 feet south & 700 feet east from NW corner Section 28
(Give distance and bearing to corner of section or other legal subdivision)

being within SW 1/4 of NW 1/4 of Sec. 28, Twp. 6S Rge. 3W
(Smallest legal subdivision) (N. or S.) (E. or W.)

or (b) within limits of recorded platted property, town or city:

in Lot _____, Block _____ of _____
(Name of plat or addition)

County of _____
(If within city or town, give name)

3. Construction Work was begun on July 10, 1953; was completed on July 11 1953
(Date) (Date)

and the ground water claimed was first used for the purposes set out below on Aug. 1953
(Date)

since which time the water has been used intermittently
(Continuously or intermittently)

from May to Sept.
(Date) (Date)

4. Quantity of water claimed and used is 300 gallons per minute; _____ acre feet per year.

5. Purpose or Purposes for which water is used Irrigation

(Domestic, irrigation, municipal, manufacturing, industrial, etc.)

6. Description of Well: Depth 26 feet. Type Drilled
(Dug or drilled)

diameter 8 inches. Elevation of ground at well site 170 feet, mean sea level.
(As near as known)

Depth to water table 14 1/2 feet.

7. Capacity of Well: 300 g.p.m. with none feet drawdown.

_____ g.p.m. with _____ feet drawdown.


Date of test _____

If Flowing Well: Measured discharge _____ g.p.m. on _____
(Date)

Shut-in pressure at ground surface _____ lbs. per sq. in. on _____
(Date)

Water is controlled by _____
(Cap, valve, etc.)

Township 65 Range 3W, W.M.
North

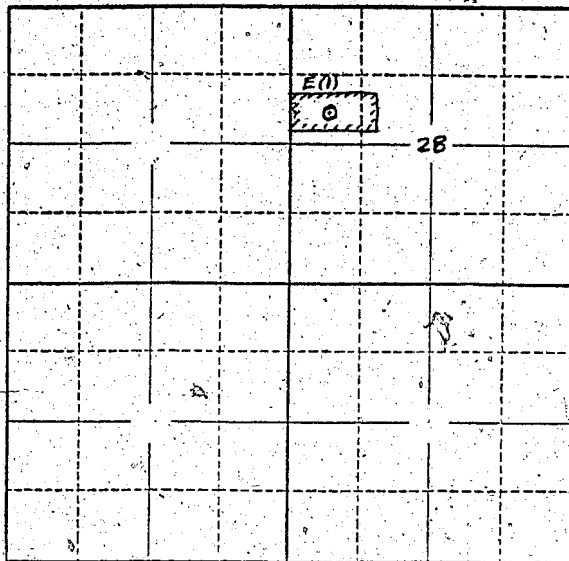

Locate well and acreage of irrigated land on plat.
Scale: 2" = 1 Mile

STATE OF OREGON

County of Marion } ss.

I, _____, being first duly sworn, do hereby certify that I have read the foregoing Registration Statement and that all of the items therein contained are true to the best of my knowledge and belief.

Albert H. Pack
(Signature of Registrant)

Subscribed and sworn to before me this 5th day of March, 1958

My commission expires 12th June 1961 Wm. S. Bartholomew
(Notary Public)

(SEAL)

CERTIFICATE OF REGISTRATION

STATE OF OREGON } ss.
County of Marion

This is to certify that the foregoing Registration Statement was received in the office of the State Engineer on the 5th day of March, 1958, at 11:00 o'clock P.M. and has been duly recorded in said office in Book No. 6 of Registration Statements on page GR-1074

Witness my hand this 30th day of June, 1958

Laura A. Stanley
(State Engineer)

By _____
(Deputy)

GR 1074